

**YALOBUSHA**  
**G 32**  
**11-1-73**

MISSISSIPPI  
 BOARD OF WATER COMMISSIONERS  
 416 North State Street  
 Jackson, Mississippi 39201

WATER WELL DRILLERS LOG

11-1 1973 LiPe well Co. Yalobusha  
 date well completed firm name county well located

LANDOWNER:  
Robert Chandler  
Water Valley Miss,  
 (mailing address)

description of formations encountered	from	to
TOP soil	0	20
red sand	20	40
sand	40	60
" "	60	80
sand	80	143

WELL LOCATION:  
 sec. 6 T. 25 N. R. 6 E.  
 S. W.  
5 miles S. W. of Water Valley  
 (distance) (direction) (nearest town)

WELL PURPOSE:  
 (home) irrigation, municipal, industrial

- WELL COMPLETION DATA:
- diameter (inches) 4"
  - total depth (feet) 143
  - static water level (feet) 90 below above top of ground.
  - casing PVC, 133,  
 (material) (depth)  
4 If telescope see back.  
 (size)
  - screen 10, 133  
 (length) (depth to top)  
4, PVC  
 (size) (material)
  - pump 3/4, 10  
 (HP) (yield gpm)  
elac.  
 (type power)
  - electric log no  
 (yes or no)  
no  
 (organization running log)
  - how well bottom plugged PVC  
cap


**CODED**

NOV 10 1973

DRILLERS REMARKS:

If well telescopes please sketch and show depths.

GROUND LEVEL

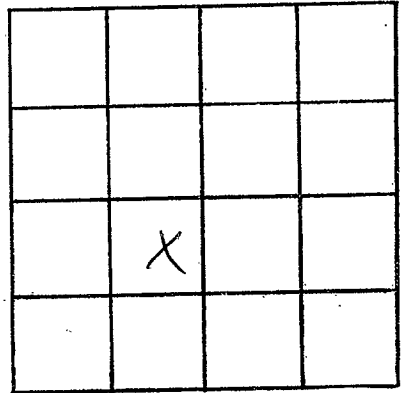

SECTION 6

Please indicate well location X.

ADDITIONAL INFORMATION

If more than one screen, show locations of each on sketch.