

**YALOBUSHA**  
**539**  
 CL-1075  
**3-11-79**

MISSISSIPPI  
 BOARD OF WATER COMMISSIONERS  
 416 North State Street  
 Jackson, Mississippi 39201

**CODED**

*Flag #69*

**WATER WELL DRILLERS LOG**

March 11, 1979 Layne Central Company Yalobusha  
 date well completed firm name county well located

LANDOWNER:	description of formations encountered	from	to
Yalobusha Water & Sewer District			
Water Valley, MS	Clay	0	70
(mailing address)	Sand	70	110
<b>WELL LOCATION:</b>	Brown Sand & stks of		
#1 sec. 15 T 25 N 6 R E	Rock	110	195
7 South Water Valley	Gray Fine Sand	195	240
(distance) miles of (direction) (nearest town)	Sandy Clay	240	260
	Clay	260	414
	Sand	414	485
<b>WELL PURPOSE:</b> Municipal	Sand & Stk of Clay	485	496
(home, irrigation, municipal, industrial)			
<b>WELL COMPLETION DATA:</b>			
(1) diameter (inches) 10"			
(2) total depth (feet) 484' 9"			
(3) static water level (feet) 177' <sup>below</sup> top of ground.			
(4) casing <u>Steel</u> 438' (material) (depth)			
<u>10"</u> if telescope see back. (size)			
(5) screen <u>41'</u> 438' (length) (depth to top)			
<u>4"</u> Stainless Steel (size) (material)			
(6) pump <u>15</u> 100 (HP) (yield gpm)			
<u>Electric</u> (type power)			
(7) electric log <u>Yes</u> (yes or no)			
<u>USGS</u> (organization running log)			
(8) how well bottom plugged <u>Back pressure valve</u>			

**CODED**

DEPT. OF NATURAL RESOURCES  
 BUREAU OF LAND & WATER RESOURCES

JAN 19 1980


**RECEIVED**

DRILLERS REMARKS:

①

If well telescopes please sketch and show depths.

GROUND LEVEL

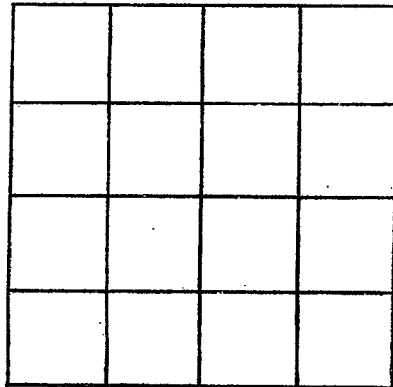

SECTION \_\_\_\_\_

Please indicate well location X.

ADDITIONAL INFORMATION

If more than one screen, show locations of each on sketch.