

**MISSISSIPPI
BOARD OF WATER COMMISSIONERS**
416 North State Street
Jackson, Mississippi 39201

WATER WELL DRILLERS LOG

Yalobusha
G 2001
4/20/76

April 20 1976 North Miss Well Drilling Yalobusha
date well completed firm name county well located

LANDOWNER: Ray L. Well

description of formations encountered	from	to
<u>Sand & Clay Str</u>	<u>0</u>	<u>70</u>
<u>Water Sand</u>	<u>70</u>	<u>100</u>

(mailing address)

WELL LOCATION:

sec. 13 T 25 N R 6 E W
6 miles N-E of Coffeeville
(distance) (direction) (nearest town)

WELL PURPOSE:

(home, irrigation, municipal, industrial)


WELL COMPLETION DATA:

- (1) diameter (inches) 2"
- (2) total depth (feet) 100
- (3) static water level (feet) 70 below ~~above~~ top of ground.
- (4) casing Plastic 100
(material) (depth)
(size) If telescope see back.
- (5) screen 10'
(length) (depth to top)
2" Skat Plastic
(size) (material)
- (6) pump 3/4 5
(HP) (yield gpm)
Electric
(type power)
- (7) electric log 70
(yes or no)

(organization running log)


(8) how well bottom plugged Plug

DRILLERS REMARKS:

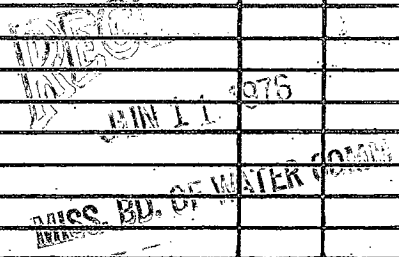

If well telescopes please sketch and show depths.

GROUND LEVEL

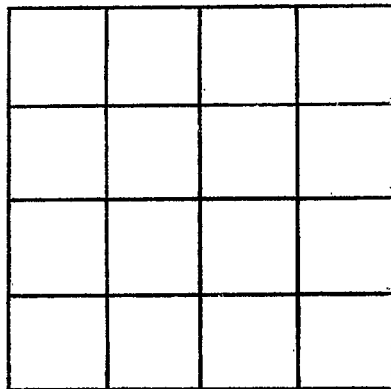

SECTION _____

Please indicate well location X.

ADDITIONAL INFORMATION

If more than one screen,
show locations of each on sketch.