

YALOBUSHA
#G 2002
2-9-77

MISSISSIPPI
 BOARD OF WATER COMMISSIONERS
 416 North State Street
 Jackson, Mississippi 39201

WATER WELL DRILLERS LOG

2-9-77 ¹⁵⁶ J B Cain Yalobusha
 date well completed firm name county well located

LANDOWNER: Claud Huse
Rt 3
Coffeeville Miss
 (mailing address)
 WELL LOCATION:
 sec 29 T 25 N R 6 E
 S W
4 miles NE of Coffeeville
 (distance) (direction) (nearest town)

WELL PURPOSE: Home
 (home, irrigation, municipal, industrial)

WELL COMPLETION DATA:
 (1) diameter (inches) 4
 (2) total depth (feet) 262
 (3) static water level (feet) 60 ^{below} above top of ground.
 (4) casing Plastic, 262,
 (material) (depth)
~~4~~ If telescope see back.
 (size)
 (5) screen 10', 252
 (length) (depth to top)
4, Plastic
 (size) (material)
 (6) pump 1 15
 (HP) (yield gpm)
Elect
 (type power)
 (7) electric log NO
 (yes or no)
 (organization running log)
 (8) how well bottom plugged Plwa

description of formations encountered	from	to
Sand	0	35
B Clay	35	95
Rock	95	97
B Clay	97	189
Rock	189	190
Clay	190	239
Sand	239	262


DRILLERS REMARKS:

RECEIVED
 FEB 14 1977

MISS. BD. OF WATER COMMISSIONERS

If well telescopes please sketch and show depths.

GROUND LEVEL

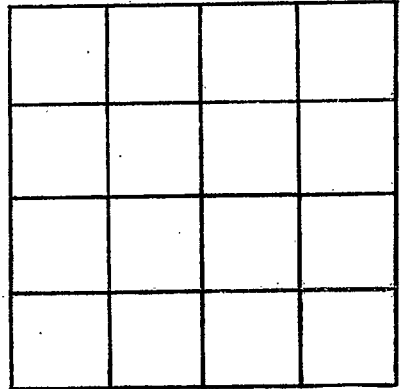

SECTION _____

Please indicate well location X.

ADDITIONAL INFORMATION

If more than one screen, show locations of each on sketch.