

# MISSISSIPPI DEPARTMENT OF NATURAL RESOURCES

Bureau of Land and Water Resources

COUNTY WELL LOCATED  
**halobusha**

WELL NUMBER **G 2003** CODED

DATE WELL COMPLETED  
**12/27/93**

PERMIT NUMBER

NAME OF DRILLING FIRM  
**Free Well Co.**

**Lope, MS.**

P.O. Box 10631  
Jackson, Mississippi 39209  
WATER WELL DRILLERS LOG

NAME & MAILING ADDRESS OF LANDOWNER  
**Larry Murphy**

**Oakland, MS.**

WELL LOCATION: SEC **9** TOWNSHIP **25** RANGE **6**  
**N** **S** **E** **W**

DISTANCE **4** Miles **E** of **Oakland**

OTHER LANDMARK

WELL PURPOSE:  Home Irrigation, Municipal, Industrial, Fish Pond, etc.

**PUMP DATA**

PUMP TYPE (Circle One):  
 Submersible Turbine, Jet Flowing Well,  
Other (Describe)

POWER TYPE (Circle One):  
 Electric Tractor, Diesel, Gasoline, Butane,  
Other (Describe) **H/P**

Pump Capacity (GPM) **10** No. of Stages Setting Depth **115** FT.

PUMP TEST

Well yielded **10** GPM with  
a drawdown of **10** ft.  
after **1** hours of pumping

**WELL DATA**

Well Depth <b>140</b>	Casing Diameter (In.) <b>4"</b>	Casing Length (Ft.) <b>130</b>
Type of Casing <b>PVC</b>	Hole Depth <b>140'</b>	Depth to Static Water Level

TYPE OF COMPLETION: (Circle One or More):  
 Gravel Packed, Underreamed, Telescoped,  
Natural Development, Open Hole, Other  
(Describe)

Top of Lap Pipe or Reduction in Casing

FEET  IF TELESCOPED OR MORE THAN ONE SCREEN: USE BACK PAGE

**LOG DATA**

TYPE OF LOG RUN (Circle One):  
Electric, Gamma Ray, Density, Sonic, Neutron,  
Other (Describe)  **No Log Run**

Name of Organization Running Log

**SCREEN DATA**

Diameter - Inches <b>4"</b>	Length - Feet <b>10</b>	Slot Size - Inches <b>.013"</b>
Screen Type <b>PVC</b>	Depth to Bottom - Feet <b>140'</b>	

**GEOLOGIC DATA (Office Use Only)**

Surface Elev.	Geologic Unit	Unit Thickness	Depth to Top
Subs. SWL	Date	Analysis	Aquifer Test

DESCRIPTION OF FORMATIONS ENCOUNTERED	FROM	TO
<b>Top Soil</b>	<b>0</b>	<b>20</b>
<b>Red sand - gravel</b>	<b>20</b>	<b>40</b>
<b>Clay</b>	<b>40</b>	<b>100</b>
<b>Sand</b>	<b>100</b>	<b>140</b>

Driller's Remarks

RECEIVED


JUN 11 1998

Dept. of Environmental Quality  
Office of Land & Water Resources

IF MORE SPACE IS NEEDED, USE BACK

If well telescopes please sketch and show depths.

GROUND LEVEL

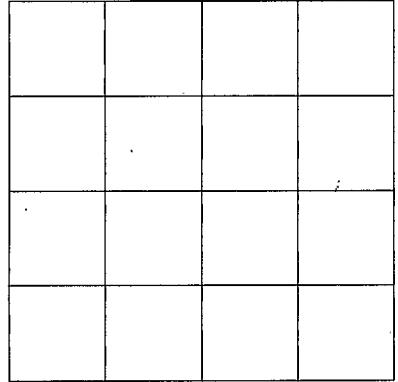

SECTION \_\_\_\_\_

Please indicate well location X.

ADDITIONAL INFORMATION

If more than one screen,  
show location of each on sketch.