

YALO.

H 2
10-15-64

WATER WELL DRILLERS LOG

CODED
CODED

Date: 10-15, 1964, Driller: J B Cain County: Panda
(Name)

(1) Owner of Land: Rip Van Winkle
(Name)
Water Valley Miss
(Address)
3257

Description & Color of Materials
Sand, Clay, Red Clay, Shell, etc.
Brd of
Sand
Blue of
Sand

Thickness Feet	Depth Feet
0	40
40	80
80	100
100	130

(2) Location: 1/4, 1/4, Sec. T R
~~1/4, 1/4, Sec. T R~~
miles ~~SE~~ of ~~Water Valley~~
(distance) (direction) (Nearest Town)

(3) Topography: (Hilly) (Flat) (Level)

(4) Purpose of Well: Home
(Domestic Irrigation, Municipal, Industrial, Other)


Information upon completion of well:

- (1) Diameter 2 inches.
- (2) Total Depth 130 feet.
- (3) Water Level 23 feet below top of ground.
- (4) Cased to 130, Size 2
- (5) Screen: Size 1/4, Length 5 FT
- (6) Were any formations sealed against pollution?
_____ yes, _____ no.

If YES depth of formation _____

Why _____

Drillers Remarks: _____

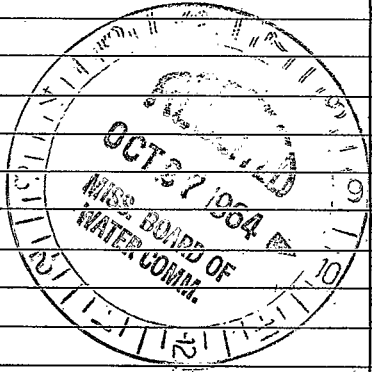

(Use Back Side)

Well No.

