

Yalobusha
CH3
12-68

MISSISSIPPI
 BOARD OF WATER COMMISSIONERS
 416 North State Street
 Jackson, Mississippi 39201

CODED

WATER WELL DRILLERS LOG

date well completed 19 68 James R. Lipe firm name Yalobusha county well located

LANDOWNER: Tal Brower

Water valley
Miss.
 (mailing address)

WELL LOCATION:

sec. 7 T. 25 N. R. 4 E.
 S. W.
10 miles S. E. of Water valley
 (distance) (direction) (nearest town)

WELL PURPOSE: Home
 (home, irrigation, municipal, industrial)

WELL COMPLETION DATA:

- (1) diameter (inches) 4"
- (2) total depth (feet) 215
- (3) static water level (feet) 80 below
top of ground.
- (4) casing Plastic, 205
(material) (depth)
10' if telescope see back.
(size)
- (5) screen 10' 205
(length) (depth to top)
4" Plastic
(size) (material)
- (6) pump 1/2 20
(HP) (yield gpm)
Elec.
(type power)
- (7) electric log No.
(yes or no)

(organization running log)

- (8) how well bottom plugged 4"
Plastic plug

DRILLERS REMARKS:

description of formations
encountered


from to

<u>red sand</u>	<u>0</u>	<u>20</u>
<u>" "</u>	<u>20</u>	<u>40</u>
<u>" "</u>	<u>40</u>	<u>60</u>
<u>" "</u>	<u>60</u>	<u>70</u>
<u>Clay and sand</u>	<u>70</u>	<u>80</u>
<u>Clay</u>	<u>80</u>	<u>100</u>
<u>" "</u>	<u>100</u>	<u>120</u>
<u>Clay</u>	<u>120</u>	<u>200</u>
<u>Sand</u>	<u>200</u>	<u>215</u>

DATE = 2 10 68
 MISS. DEPT. OF
 WATER RESOURCES

If well telescopes please sketch and show depths.

GROUND LEVEL

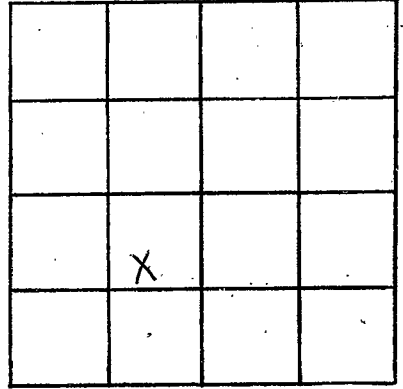

SECTION 2

Please indicate well location X.

ADDITIONAL INFORMATION

If more than one screen,
show locations of each on sketch.