

Big Stream

MISSISSIPPI
BOARD OF WATER COMMISSIONERS
416 North State Street
Jackson, Mississippi 39201

CODED

YALOBUSHA
H7
1-9-75

WATER WELL DRILLERS LOG


Jan 9 1975 J. B. Cain Yalobusha
date well completed firm name county well located

LANDOWNER:	description of formations encountered	from	to
C. H. Hooper Coffeeville Miss (mailing address)	Sand	0	160
WELL LOCATION: sec. 5 T. 25 N. R. 7 E 9 miles N-E of Coffeeville (distance) (direction) (nearest town)	Blue Clay & Redop	160	350
WELL PURPOSE: Home (home, irrigation, municipal, industrial)	Water Sand	350	650
WELL COMPLETION DATA: (1) diameter (inches) 4" (2) total depth (feet) 650 (3) static water level (feet) 120 below top of ground. (4) casing PLASTIC 3 1/2" (material) (depth). (size) if telescope see back. (5) screen 7/8" (length) (depth to top) (size) (material) (6) pump 3/4 (HP) 10 (yield gpm) Elec (type power) (7) electric log No (yes or no) (organization running log) (8) how well bottom plugged open	CODED		
DRILLERS REMARKS: Ruff			

RECEIVED
JAN 15 1975
MISS. BD. OF WATER COMMISSIONERS

If well telescopes please sketch and show depths.

GROUND LEVEL

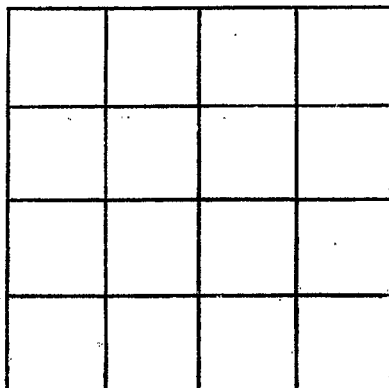

SECTION _____

Please indicate well location X.

ADDITIONAL INFORMATION

If more than one screen, show locations of each on sketch.