

YALOBUSHA  
H 8  
3-6-75

MISSISSIPPI  
BOARD OF WATER COMMISSIONERS  
416 North State Street  
Jackson, Mississippi 39201

CODED


WATER WELL DRILLERS LOG

March 6 1975 Nelson Cain Yalobusha  
date well completed firm name county well located

LANDOWNER: <u>XX Hunting Club</u>	description of formations encountered	from	to
(mailing address)	Brown Clay	0	40
WELL LOCATION: sec. <u>19</u> T <u>25</u> N R <u>7</u> E <u>6</u> miles <u>N-E</u> of <u>Coffeewillie</u> (distance) (direction) (nearest town)	Blue Clay	40	65
WELL PURPOSE: <u>Deer Camp</u> (home, irrigation, municipal, industrial)	Sand	65	80
WELL COMPLETION DATA:	CODED		
(1) diameter (inches) <u>2"</u>			
(2) total depth (feet) <u>80</u>			
(3) static water level (feet) <u>50</u> below top of ground.			
(4) casing <u>Plastic</u> , <u>80</u> (material) (depth)			
_____ If telescope see back. (size)			
(5) screen <u>10'</u> , <u>70</u> (length) (depth to top)			
<u>2"</u> , <u>Plastic</u> (size) (material)			
(6) pump <u>7/4</u> , <u>3</u> (HP) (yield gpm)			
<u>Elec</u> (type power)			
(7) electric log <u>No</u> (yes or no)			
_____ (organization running log)			
(8) how well bottom plugged <u>Back Bit</u>			
DRILLERS REMARKS:	RECEIVED MAR 31 1975 MISS. BD. OF WATER COMMISSIONERS		

If well telescopes please sketch and show depths.

GROUND LEVEL

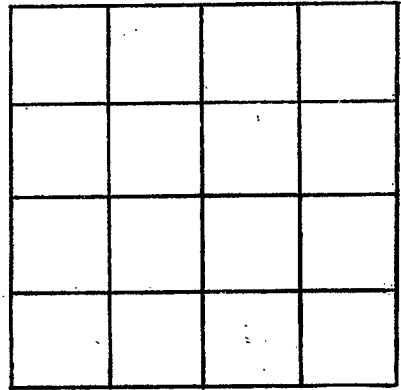

SECTION \_\_\_\_\_

Please indicate well location X.

ADDITIONAL INFORMATION

If more than one screen, show locations of each on sketch.