

YALOBUSHA  
 H12  
 11/78  
 E Lic #63

MISSISSIPPI  
 BOARD OF WATER COMMISSIONERS  
 416 North State Street  
 Jackson, Mississippi 39201

CODED

WATER WELL DRILLERS LOG

Nov 78 date well completed  
 Robert E. Ruffin Co Inc firm name  
 Yalobusha county well located

LANDOWNER: Youngs Water Assoc. Well #1

description of formations encountered	from	to
Top Soil	0	10
SAND	10	45
Shale	45	80
Sand	80	180
Shale & Sand streaks	180	300
Sand	300	420

(mailing address)

WELL LOCATION:  
 sec. 1 T 23 N R 7 E  
30 miles East of Overton  
 (distance) (direction) (nearest town)

WELL PURPOSE: Municipal  
 (home, irrigation, municipal, industrial)

- WELL COMPLETION DATA:
- (1) diameter (inches) 10" x 4'
  - (2) total depth (feet) 380
  - (3) static water level (feet) 255 <sup>below</sup> <sub>above</sub> top of ground.
  - (4) casing Steel 340  
 (material) (depth)  
10 if telescope see back.  
 (size)
  - (5) screen 40' 340  
 (length) (depth to top)  
4 5.55  
 (size) (material)
  - (6) pump 20 100  
 (HP) (yield gpm)  
electric  
 (type power)
  - (7) electric log Yes  
 (yes or no)  
STATE  
 (organization running log)
  - (8) how well bottom plugged BPU

Miss. Board of Water Comm.



SEP 12 1979

RECEIVED

DRILLERS REMARKS:

(7)

If well telescopes please sketch and show depths.

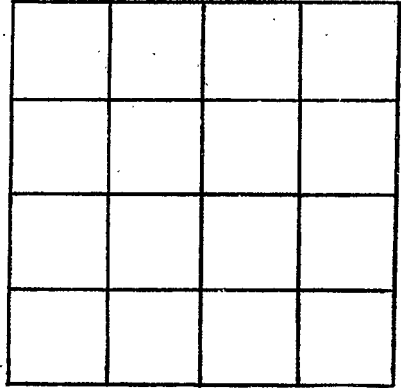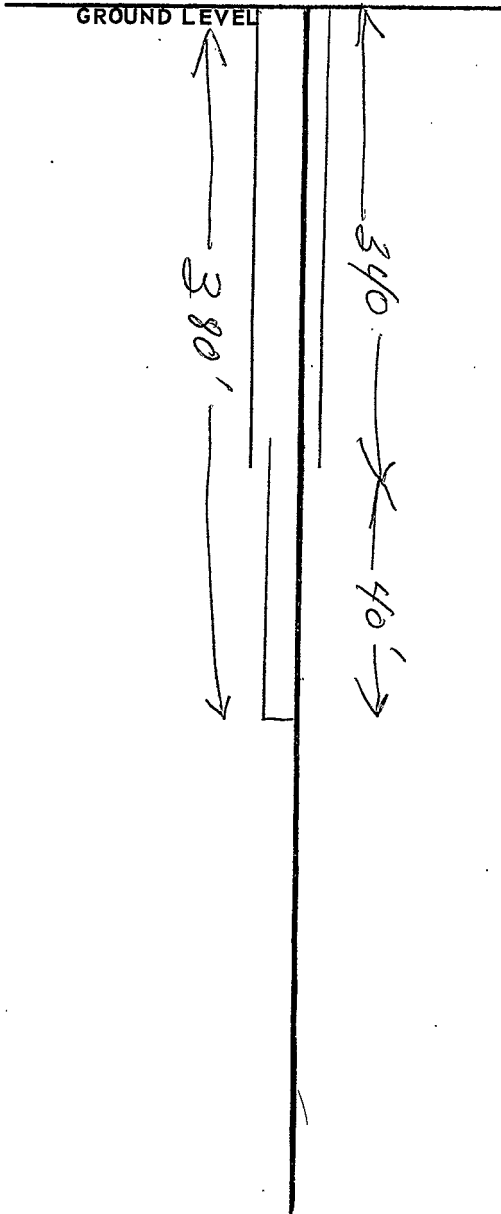

SECTION \_\_\_\_\_

Please indicate well location X.

ADDITIONAL INFORMATION


If more than one screen, show locations of each on sketch.