

MISSISSIPPI DEPARTMENT OF NATURAL RESOURCES

Bureau of Land and Water Resources

Southport Mall

P.O. Box 10631

Jackson, Mississippi 39209

WATER WELL DRILLERS LOG

COPIED

VALDUSHA
~~CL-1542~~
 CL-1542
8-21-81

Ref. H14
 Eng # 70

8-21 19 81 Layne-Central Company Valobusha
 date well completed firm name county well located

LANDOWNER:	description of formations encountered	from	to
Yalobusha Water & Sewer Dist. Pine Valley, MS (mailing address)			
WELL LOCATION: sec. <u>1</u> T. <u>25</u> N. R. <u>3</u> E <u>3</u> miles (distance) of Pine Valley (nearest town)	Sandy clay & St of sa	81	117
WELL PURPOSE: <u>municipal</u> (home, irrigation, municipal, industrial)	Brown sand	117	212
WELL COMPLETION DATA: (1) diameter (inches) <u>19"</u>	Shale	212	255
(2) total depth (feet) <u>519' 6"</u>	Sandy clay	255	280
(3) static water level (feet) <u>74' 6" below</u> top of ground.	Clay	280	431
(4) casing <u>steel</u> <u>473'</u> (material) (depth)	Sand	431	517
<u>10"</u> (size) if telescope see back.	Sand & Sts. of clay	517	529
(5) screen <u>41' 3"</u> (length), <u>473' 408' 9"</u> (depth to top)			
<u>4</u> (size), <u>st. steel</u> (material)			
(6) pump <u>25</u> (HP), <u>150</u> (yield gpm)			
<u>elec.</u> (type power)			
(7) electric log <u>yes</u> (yes or no)			
<u>U.S.G.C.</u> (organization running log)			
(8) how well bottom plugged <u>back pressure valve</u>			
DRILLERS REMARKS:			

COPIED

4' 3"

475
415
516




①

If well telescopes please sketch and show depths.

GROUND LEVEL

200 - 300'

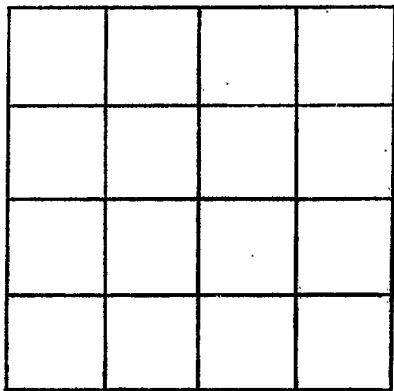

SECTION _____

Please indicate well location X.

ADDITIONAL INFORMATION

If more than one screen, show locations of each on sketch.