

Yalobusha
H 2001
10-19-77

MISSISSIPPI
BOARD OF WATER COMMISSIONERS
416 North State Street
156 Jackson, Mississippi 39201

WATER WELL DRILLERS LOG

10-19 1977 Lipe Well Co. Yalobusha
date well completed firm name county well located

LANDOWNER:
David Parker
Coffeeville MS.
(mailing address)

| description of formations encountered | from | to |
|---------------------------------------|------|-----|
| TOP SOIL | 0 | 20 |
| red sand | 20 | 40 |
| black clay | 40 | 60 |
| sand and clay | 60 | 80 |
| sand | 80 | 118 |

WELL LOCATION:
sec. 16 T-25 N R-7 E
5 miles N. East of oakland
(distance) (direction) (nearest town)

WELL PURPOSE:
(home irrigation, municipal, industrial)

- WELL COMPLETION DATA:
- (1) diameter (inches) 4
 - (2) total depth (feet) 118
 - (3) static water level (feet) 80 below above top of ground.
 - (4) casing PVC 108 (material) (depth)
4 (size) if telescope see back.
 - (5) screen 10 108 (length) (depth to top)
4 PVC (size) (material)
 - (6) pump 3/4 10 (HP) (yield gpm)
elec. (type power)
 - (7) electric log NO (yes or no)
NO (organization running log)
 - (8) how well bottom plugged PVC PLUS


RECEIVED
NOV - 7 1977

DRILLERS REMARKS:

MISS. BD OF WATER COMMISSIONERS

If well telescopes please sketch and show depths.

GROUND LEVEL

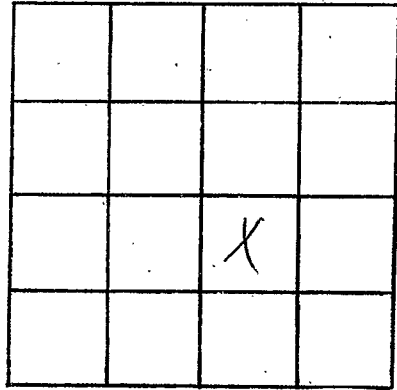

SECTION 16

Please indicate well location X.

ADDITIONAL INFORMATION

Lined area for additional information.

If more than one screen, show locations of each on sketch.