

YALO,

J 5

2-26-61

WATER WELL DRILLERS LOG

CODED

Yalobusha
Ponate

Date: 2-26, 19 61

Driller: Jas. R. Lipe (Name)

County

(1) Owner of Land: Thomas C. Carpenter
(Name)

Deakley, Miss
(Address)

(2) Location: 1/4, 1/4, Sec. 21 T. 24 R. 4
E

1 miles West, of Deakley
(distance) (direction) (Nearest Town)

(3) Topography: Hilly
(Hilly) (Level)

(4) Purpose of Well: Domestic
(Domestic, Irrigation, Municipal, Industrial, Other)

Description & Color of Materials Sand, Clay, Red Clay, Shell, etc.	Thick- ness Feet	Depth Feet
Clay	0	25
gravel	25	55
Sand & gravel	55	60
Sand	60	100
graying sand	100	117

Information upon completion of well:

(1) Diameter 2 inches.

(2) Total Depth 117 feet.

(3) Water Level 100 feet below top of ground.

(4) Cased to 111, Size 2


(5) Screen: Size 1/4, Length 6'

(6) Were any formations sealed against pollution?
 _____ yes, _____ no.

If YES depth of formation _____

Why _____

Drillers Remarks: _____

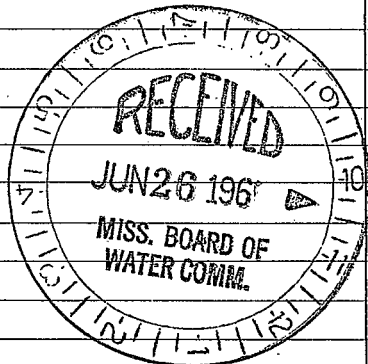

(Use Back Side)

Well No.

