

YALO.
J 7

WATER WELL DRILLERS LOG

CODED

Date: 11-15, 1963, Driller: James R. Lipe County Attala
(Name)

11-15-63

(1) Owner of Land: B. H. Harris
(Name)

Leakey
(Address)

(2) Location: 1/4, 1/4, Sec: 23 24 6
(T.N.R. 24)

3 miles west of Leakey
(distance) (direction) (Nearest Town)

(3) Topography: Hilly
(Hilly) (Flat) (Level)

(4) Purpose of Well: Dom.
(Domestic Irrigation
Municipal, Industrial, Other)

Description & Color of Materials
Sand, Clay, Red Clay, Shell, etc.

Thick-
ness
Feet

Depth
Feet

Clay	0	30
Clay & gravel	30	65
gravel & sand	65	90
W/Sand	90	119

Information upon completion of well:

(1) Diameter 2 inches.

(2) Total Depth 119 feet.

(3) Water Level 50 feet below top of ground.

(4) Cased to 111, Size 2"

(5) Screen: Size 1/4, Length 6'


(6) Were any formations sealed against pollution?

no

If YES depth of formation _____

Why _____

Drillers Remarks: _____

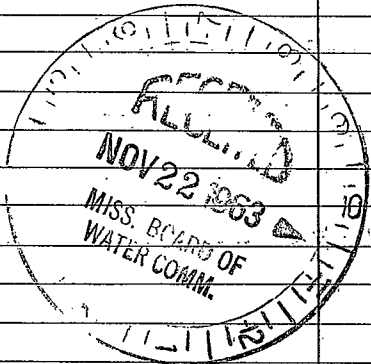

119

Well No.

(Use Back Side)

