

YALOB. MISSISSIPPI BOARD OF WATER COMMISSIONERS

J 9

3-4-66

James Ray Lipe
WATER WELL DRILLERS LOG

CODED


Date: 3-4-64 19', Driller: Frank Taylor County: Panola
(Name)

(1) Owner of Land:	Description & Color of Materials Sand, Clay, Red Clay, Shell, etc.	Thick- ness Feet	Depth Feet
J. R. Crawford (Name) Zettletown (Address)	Clay	0	40
(2) Location: 1/4, 1/4, Sec. 4 T. 24 N. R. 11 W. 3 miles West of Zettletown (distance) (direction) (Nearest Town)	Clay & Sand	40	60
(3) Topography: Hilly (Hilly) (Flat) (Level)	Sand	60	75
(4) Purpose of Well: Dom. (Domestic Irrigation Municipal, Industrial, Other)	ry Sand	75	90

Information upon completion of well:

- (1) Diameter 2" inches.
- (2) Total Depth 94 feet.
- (3) Water Level 60 feet below top of ground.
- (4) Cased to 84, Size 2
- (5) Screen: Size 1/4, Length 6'
- (6) Were any formations sealed against pollution?
_____ yes, _____ no.

If YES depth of formation _____
Why _____
Drillers Remarks: _____

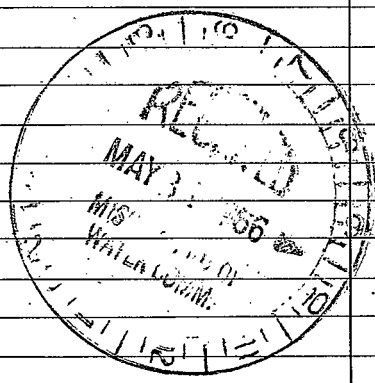

(Use Back Side)

Well No.

