

YALOB. MISSISSIPPI BOARD OF WATER COMMISSIONERS

J 11

4-8-66

James A. Lipe
WATER WELL DRILLERS LOG

CODED

Date: 4-8, 1966, Driller: Frank Taylor County Darwin
(Name)

(1) Owner of Land: Oliver Rebeton
(Name)
Acakey
(Address)

(2) Location: 1/4, 1/4, Sec. 14 T34 R4
N E
1 miles West of Acakey
(distance) (direction) (Nearest Town)

(3) Topography: Hilly
(Hilly) (Flat) (Level)

(4) Purpose of Well: Domestic
(Domestic Irrigation
Municipal, Industrial, Other)

Description & Color of Materials Sand, Clay, Red Clay, Shell, etc.	Thick- ness Feet	Depth Feet
<u>Clay</u>	<u>0</u>	<u>80</u>
<u>clay & sand</u>	<u>80</u>	<u>110</u>
<u>W/S sand</u>	<u>110</u>	<u>154</u>

Information upon completion of well:

(1) Diameter 4 inches.

(2) Total Depth 154 feet.

(3) Water Level 110 feet below top of ground.

(4) Cased to 148, Size 4


(5) Screen: Size 4", Length 4'

(6) Were any formations sealed against pollution?
_____ yes, _____ no.

If YES depth of formation _____

Why _____

Drillers Remarks: _____

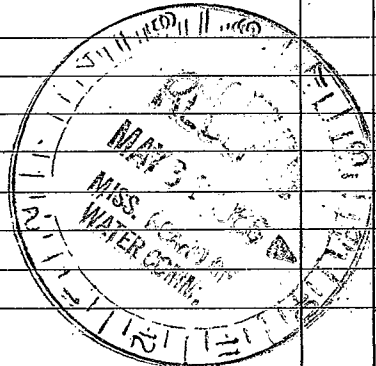

(Use Back Side)

Well No.

