

**YALOBUSHA**  
**J13**  
**4-25-74**

**MISSISSIPPI**  
**BOARD OF WATER COMMISSIONERS** **CODED**  
 416 North State Street  
 Jackson, Mississippi 39201

**WATER WELL DRILLERS LOG**

4-25 1974 Life Well Co. Yalobusha  
 date well completed firm name county well located

**LANDOWNER:**  
Dan P. Vrooman  
Scobey Miss.  
 (mailing address)

description of formations encountered	from	to
Top Soil	0	20
Gravel	20	40
"	40	60
Sand	60	80
blue clay	80	100
sand	100	116

**WELL LOCATION:**  
 sec. 34 T 24 N R 4 E  
1/2 miles N.W. of Scobey  
 (distance) (direction) (nearest town)

**WELL PURPOSE:**  
 (home irrigation, municipal, industrial)  
home irrigation

**WELL COMPLETION DATA:**

(1) diameter (inches) 4

(2) total depth (feet) 116

(3) static water level (feet) 80 below top of ground.

(4) casing PVC 106  
 (material) (depth)

4 If telescope see back.  
 (size)

(5) screen 10 116  
 (length) (depth to top)

4 PVC  
 (size) (material)

(6) pump 3/4 10  
 (HP) (yield gpm)

elec.  
 (type power)

(7) electric log no  
 (yes or no)

no  
 (organization running log)

(8) how well bottom plugged PVC  
plug


**CODED**

**DRILLERS REMARKS:**

MAY 1 1974  
 MISS. DEPT. OF WATER CONTROL

If well telescopes please sketch and show depths.

GROUND LEVEL

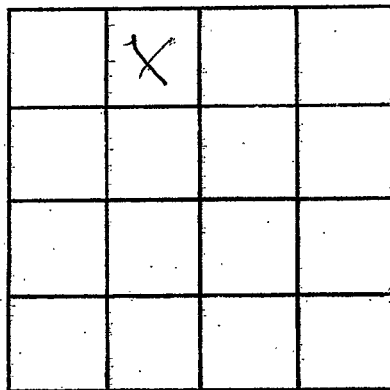

SECTION 34

Please indicate well location X.

ADDITIONAL INFORMATION

If more than one screen, show locations of each on sketch.