

J K

4-28-62

WATER WELL DRILLERS LOG

CODED CODED

4-28 62

J. B. Cain

Yalobush

Date: _____, 19____, Driller: _____ County _____

(Name)

HENRY FARMER

(1) Owner of Land: Henry Farmer
 (Name) Root 1
 (Address) 32 2/4 N

Description & Color of Materials
 Sand, Clay, Red Clay, Shell, etc.

Thickness Feet
 Depth Feet

(2) Location: 4 SW 1/4, 4 Sec 8 T R
4 S-W 20 mi
 (distance) (direction) (Nearest Town)

Gravel
land

20
90
140

(3) Topography: Home
 (Hilly) (Flat) (Level)

(4) Purpose of Well: Home
 (Domestic Irrigation
 Municipal, Industrial, Other)

Information upon completion of well:

(1) Diameter 2 inches.

(2) Total Depth 105 feet.

(3) Water level 74 feet below top of ground.


(4) Cased to 105 feet, Size 2"

(5) Screen: Size 2", Length 5 FT

(6) Were any formations sealed against pollution?
 _____ yes, _____ no.

If YES depth of formation _____
 Why _____

Drillers Remarks: _____

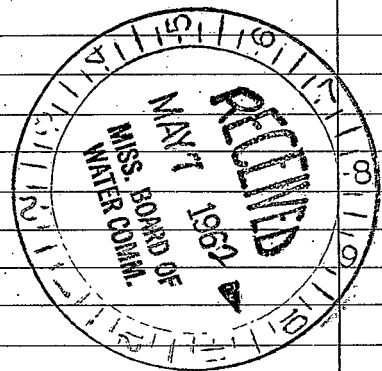

(Use Back Side)

Well No.

