

YALOBUSHA
 518
 7-9-64

MISSISSIPPI BOARD OF WATER COMMISSIONERS

WATER WELL DRILLERS LOG

CODED
 CODED

Date: July 9, 1964, Driller: Robert E. Ratliff County Leflore
 (Name)


(1) Owner of Land:	Description & Color of Materials Sand, Clay, Red Clay, Shell, etc.	Thick- ness Feet	Depth Feet
<u>Jimmy Jones</u> (Name) <u>Water Valley, Miss</u> (Address)	<u>Red clay sand</u>	<u>0</u> <u>9</u>	<u>9</u> <u>2 1/2</u>
(2) Location: <u>1/4</u> , <u>1/4</u> , <u>Sec 7 24 4</u> <u>4</u> <u> </u> miles <u> </u> of <u> </u> (distance) (direction) (Nearest Town)			
(3) Topography: <u>Hilly</u> (Hilly) (Flat) (Level)			
(4) Purpose of Well: <u>Domestic</u> (Domestic Irrigation Municipal, Industrial, Other)			

Information upon completion of well:

- (1) Diameter 2 inches.
- (2) Total Depth 212 feet.
- (3) Water Level 126 feet below top of ground.
- (4) Cased to 212, Size 2
- (5) Screen: Size 2, Length 5
- (6) Were any formations sealed against pollution?
 yes, no.

If YES depth of formation _____
 Why _____

Drillers Remarks: _____

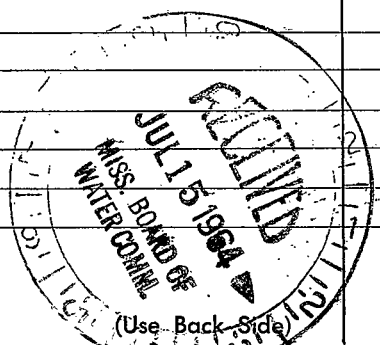

Well No. _____

