

YALOB.

MISSISSIPPI BOARD OF WATER COMMISSIONERS

J 20

3-5-64

WATER WELL DRILLERS LOG

Jallopetchie

Date: March 5, 1964, Driller: Frank Taylor County Franklin

(Name)

(1) Owner of Land: Fernand J. Herber  
(Name)  
Scalvey  
(Address)

Description & Color of Materials Sand, Clay, Red Clay, Shell, etc.	Thick- ness Feet	Depth Feet
<u>Clay</u>	<u>0</u>	<u>15</u>
<u>Sandy gravel</u>	<u>15</u>	<u>110</u>
<u>W/Shell</u>	<u>110</u>	<u>119</u>

(2) Location: 1/4, 1/4, Sec. 6 T. 23 N. R. 4 E.,  
4 miles West, of Hardy,  
(distance) (direction) (Nearest Town)

(3) Topography: Hilly  
(Hilly) (Flat) (Level)

(4) Purpose of Well: Domestic  
(Domestic Irrigation  
Municipal, Industrial, Other)

CODED

Information upon completion of well:

(1) Diameter 2 inches.

(2) Total Depth 119 feet.

(3) Water Level 40 feet below top of ground.

(4) Cased to 113, Size 2

(5) Screen: Size 1/4, Length 6

(6) Were any formations sealed against pollution?

CODED


CODED

yes, no.

If YES depth of formation

Why

Drillers Remarks:

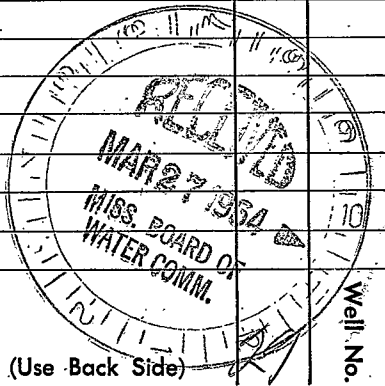

(Use Back Side)

