

Yalobusha  
J 2000  
9-23-75

MISSISSIPPI  
 BOARD OF WATER COMMISSIONERS  
 416 North State Street  
 Jackson, Mississippi 39201

WATER WELL DRILLERS LOG

9-23 1975 Robert E. Parloff Co Inc Yalobusha  
 date well completed firm name county well located

LANDOWNER: GRENADE SAND

description of formations encountered	from	to
<u>Sand</u>	<u>0</u>	<u>70</u>
<u>SHALE</u>	<u>70</u>	<u>100</u>
<u>Clay</u>	<u>100</u>	<u>180</u>
<u>Sand</u>	<u>180</u>	<u>190</u>
<u>CLAY</u>	<u>190</u>	<u>200</u>
<u>Shale</u>	<u>200</u>	<u>300</u>
<u>CLAY</u>	<u>300</u>	<u>340</u>
<u>SAND</u>	<u>340</u>	<u>500</u>


+ GRAVEL

GRENADE MS  
 (mailing address)

WELL LOCATION:  
 sec. 23 T 24 N R. 4 E  
8 <sup>3</sup> SE of Tillatoba  
8 miles N of GRENADE  
 (distance) (direction) (nearest town)

WELL PURPOSE: Shop  
 (home, irrigation, municipal, industrial)

- WELL COMPLETION DATA:
- diameter (inches) 4X2
  - total depth (feet) 500
  - static water level (feet) \_\_\_\_\_ below/above top of ground.
  - casing 4X2 (material), 494 (depth)  
4X2 (size) if telescope see back.
  - screen 6 (length), 494 (depth to top)  
2" (size), SS (material)
  - pump 1 1/2 (HP), 20 (yield gpm)  
electric (type power)
  - electric log yes (yes or no)  
MS CS (organization running log)
  - how well bottom plugged BPC

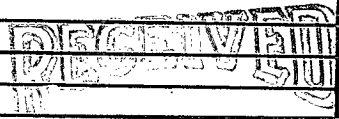

DRILLERS REMARKS: \_\_\_\_\_

MISS. BD. OF WATER COMMISSIONERS

