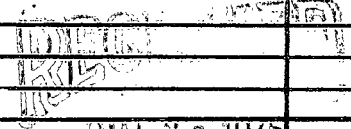


Yalobusha
J 2001
10-7-75

MISSISSIPPI
 BOARD OF WATER COMMISSIONERS
 416 North State Street
 Jackson, Mississippi 39201


WATER WELL DRILLERS LOG

Oct. 7 1975 LiPe Well Co. Yalobusha
 date well completed firm name county well located

LANDOWNER:	description of fomations encountered	from	to
<u>Brewer Martin</u>			
<u>Scobey Miss.</u> (mailing address)	<u>sand</u>	<u>20</u>	<u>40</u>
	<u>gravel</u>	<u>40</u>	<u>60</u>
	<u>rock</u>	<u>60</u>	<u>65</u>
	<u>clay</u>	<u>65</u>	<u>80</u>
	<u>clay and sand</u>	<u>80</u>	<u>100</u>
	<u>sand</u>	<u>100</u>	<u>120</u>
WELL LOCATION: sec. <u>33</u> T <u>24</u> N R <u>4</u> E 15F <u>2</u> miles <u>S.W.</u> of <u>Scobey</u> (distance) (direction) (nearest town)			
WELL PURPOSE: (<u>home</u>) irrigation, municipal, industrial)			
WELL COMPLETION DATA:			
(1) diameter (inches) <u>4"</u>			
(2) total depth (feet) <u>120</u>			
(3) static water level (feet) <u>60</u> below top of ground.			
(4) casing <u>PVC</u> <u>110</u> (material) (depth)			
<u>4</u> if telescope see back. (size)			
(5) screen <u>10</u> <u>110</u> (length) (depth to top)			
<u>4</u> <u>PVC</u> (size) (material)			
(6) pump <u>3/4</u> <u>10</u> (HP) (yield gpm)			
<u>elec.</u> (type power)			
(7) electric log <u>no</u> (yes or no)			
<u>no</u> (organization running log)			
(8) how well bottom plugged <u>PVC</u> <u>plug</u>			
DRILLERS REMARKS: <div style="text-align: right; margin-top: 20px;">  OCT 30 1975 MISS. Bd. of WATER COMM. </div>			

If well telescopes please sketch and show depths.

GROUND LEVEL

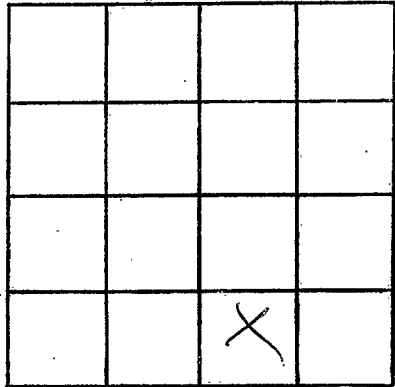

SECTION 33

Please indicate well location X.

ADDITIONAL INFORMATION

If more than one screen, show locations of each on sketch.