

YALOBUSHA
K4
5-27-74

MISSISSIPPI
BOARD OF WATER COMMISSIONERS
416 North State Street
Jackson, Mississippi 39201

CODED

WATER WELL DRILLERS LOG

5-27 1974 Lipe Well Co. Yalobusha
date well completed firm name county well located

LANDOWNER:
Bobby Robertson
Coffeeville Miss.
(mailing address)

description of formations encountered	from	to
Top soil	0	20
red sand	20	40
" "	40	60
White clay	60	80
sand and clay	80	100
" " "	100	120
" " "	120	140
sand and clay	140	162

WELL LOCATION:
sec. 16 T. 24 N. R. 5 E
6 miles west of Coffeeville
(distance) (direction) (nearest town)

WELL PURPOSE:
(home, irrigation, municipal, industrial)


- WELL COMPLETION DATA:
- (1) diameter (inches) 4
 - (2) total depth (feet) 162
 - (3) static water level (feet) 80 below top of ground.
 - (4) casing PVC 152 (material), (depth)
4 (size) If telescope see back.
 - (5) screen 10 152 (length), (depth to top)
4 PVC (size), (material)
 - (6) pump 3/4 10 (HP), (yield gpm)
elec. (type power)
 - (7) electric log NO (yes or no)
NO (organization running log)
 - (8) how well bottom plugged PVC Plug

CODED

DRILLERS REMARKS:

If well telescopes please sketch and show depths.

GROUND LEVEL

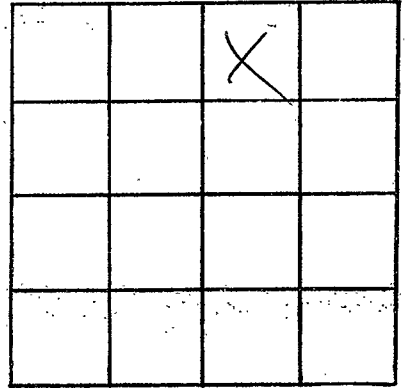

SECTION 16

Please indicate well location X.

ADDITIONAL INFORMATION

If more than one screen,
show locations of each on sketch.