

K 7

CODED
MISSISSIPPI
BOARD OF WATER COMMISSIONERS
 416 North State Street
 Jackson, Mississippi 39201

WATER WELL DRILLERS LOG

5-4-92 19 Lipt Well Supply Yalobusha
 date well completed firm name county well located
Agnewell Church

LANDOWNER: James Norton
Rt 3, (PO Box 432)
Coffeyville, Ms 38922
 (mailing address)

WELL LOCATION:
 sec. 12 T. 24 N R. 5 E
3 miles SW of Coffeyville
 (distance) (direction) (nearest town)

WELL PURPOSE:
 (home, irrigation, municipal, industrial)

WELL COMPLETION DATA:

(1) diameter (inches) 4"

(2) total depth (feet) 160'

(3) static water level (feet) 110 below top of ground.

(4) casing PVC 150'
 (material) (depth)

4 If telescope see back.
 (size)

(5) screen 10' 150'
 (length) (depth to top)

4" PVC
 (size) (material)

(6) pump 1/2 10
 (HP) (yield gpm)

elec
 (type power)

(7) electric log (yes or no) (no)

(organization running log)

(8) how well bottom plugged Capped

description of formations encountered	from	to
top soil, then sand w/ few streaks of clay	0	20
sand then rock bit 23'	20	40
back to sand		
sand w/ few streaks of clay, rock at 55'	40	60
sand w/ very little clay at bottom	60	80
clay, then sand, then hard clay (6')	80	100
hard clay, then sand lat 112', with rock at 117'	100	120
sand w/ small streak of clay	120	140
sand	140	160


RECEIVED
RECEIVED
 MAY 14 1992

Dept. of Environmental Quality
 Bureau of Land & Water Resources

DRILLERS REMARKS:

If well telescopes please sketch and show depths.

GROUND LEVEL

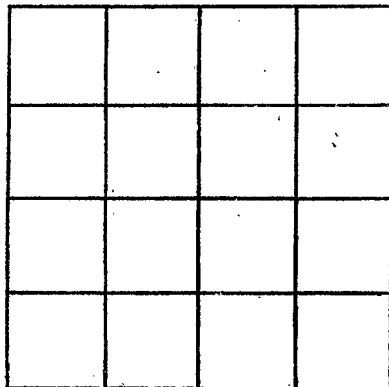

SECTION _____

Please indicate well location X.

ADDITIONAL INFORMATION

If more than one screen, show locations of each on sketch.