

Yalobusha
K 2000
11/1/76

MISSISSIPPI
 BOARD OF WATER COMMISSIONERS
 416 North State Street
 Jackson, Mississippi 39201

WATER WELL DRILLERS LOG

11-1 ¹⁵⁶ 76 Lipe Well Co. Yalobusha
 date well completed firm name county well located

LANDOWNER:
H. B. Basseg
Tillatoba MS.
 (mailing address)

WELL LOCATION:
 sec. 5 T 20 N R 6 E
4 miles East of Tillatoba
 (distance) (direction) (nearest town)

WELL PURPOSE:
 (home) irrigation, municipal, industrial

WELL COMPLETION DATA:

- (1) diameter (inches) 4
- (2) total depth (feet) 163
- (3) static water level (feet) 60 below top of ground.
- (4) casing PVC 153
 (material) (depth)
4 if telescope see back.
 (size)
- (5) screen 10 153
 (length) (depth to top)
4 PVC
 (size) (material)
- (6) pump 3/4 10
 (HP) (yield gpm)
elec.
 (type power)
- (7) electric log NO
 (yes or no)
NO
 (organization running log)
- (8) how well bottom plugged PVC
cap

description of formations encountered	from	to
TOP soil	0	20
sand	20	40
ll	40	60
black clay	60	80
ll ll	80	100
sand and clay	100	120
ll ll ll	120	140
sand	140	163


RECEIVED
 DEC 20 1976

MISS. BD. OF WATER COMMISSIONERS

DRILLERS REMARKS:

If well telescopes please sketch and show depths.

GROUND LEVEL

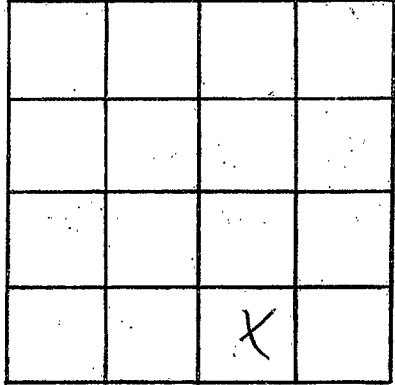

SECTION 5

Please indicate well location X.

ADDITIONAL INFORMATION

A series of horizontal lines for writing additional information.

If more than one screen, show locations of each on sketch.