

Yalobusha  
 L 19  
 7-68  
 MS68  
 July, 1968  
 date well completed

MISSISSIPPI  
 BOARD OF WATER COMMISSIONERS  
 416 North State Street  
 Jackson, Mississippi 39201

*Coiled*

WATER WELL DRILLERS LOG

Robert E. Rattiff Co Yalobusha  
 firm name county well located


LANDOWNER: *Levan G Coffeeville*  
*Coffeeville Miss*  
 (mailing address)

description of formations encountered	from	to
Top Soil	0	6
White sand	6	25
White sand	25	60
Shale	60	72
Shale, sand, strks.	72	96
Rock	96	97
Shale	97	143
Shale, sand strks	143	237
Shale	237	308
Rock	308	309 1/2
Shale	309 1/2	333
Shale, rocks	333	357
Shale, sand strks.	357	381
Shale	381	395
Shale, sand strks	395	400
Sand - Wileyad	400	425
Shale, sandy	425	492
Sandy shale	492	500
Sandy shale	500	526

WELL LOCATION:  
 sec. 4 T 24 (N) R 6 (E)  
 S W  
*in town*  
 (distance) (direction) (nearest town)

WELL PURPOSE: *Municipal*  
 (home, irrigation, municipal, industrial)

WELL COMPLETION DATA:  
 (1) diameter (inches) 10 X 6  
 (2) total depth (feet) 458  
 (3) static water level (feet) 12 <sup>below</sup> <sub>above</sub> top of ground.  
 (4) casing Bst. 405'  
 (material) (depth)  
10"  
 (size) if telescope see back.  
 (5) screen 40' 418  
 (length) (depth to top)  
6" D.S.  
 (size) (material)  
 (6) pump 40 4500  
 (HP) (yield gpm)  
electric  
 (type power)  
 (7) electric log yes <sup>(MSGS elog 37)</sup>  
 (yes or no)  
U.S.G.S.  
 (organization running log)  
 (8) how well bottom plugged S.S.  
plate

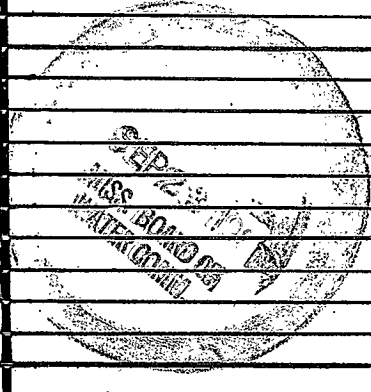


DRILLERS REMARKS:

①

If well telescopes please sketch and show depths.

GROUND LEVEL

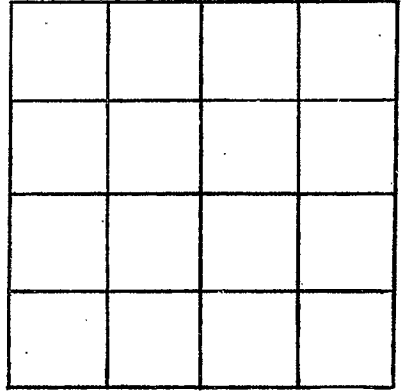

SECTION \_\_\_\_\_

Please indicate well location X.

ADDITIONAL INFORMATION

If more than one screen, show locations of each on sketch.