

YAL0.

MISSISSIPPI BOARD OF WATER COMMISSIONERS

L 21

WATER WELL DRILLERS LOG

7-10-64

Date: 7-10, 1964, Driller:

J B Cain County Panola

(Name)

(1) Owner of Land: Bob J Bell
 (Name)
Coffenville
 (Address)

(2) Location: $\frac{1}{4}$, 23, $\frac{1}{4}$, Sec. 24^N, 6^E
 T R

3 miles E, of Coffenville
 (distance) (direction) (Nearest Town)

(3) Topography: (Hilly) (Flat) (Level)

(4) Purpose of Well: Home
 (Domestic Irrigation, Municipal, Industrial, Other)

Description & Color of Materials Sand, Clay, Red Clay, Shell, etc.	Thick- ness Feet	Depth Feet
<u>Bro Cl</u>	<u>0</u>	<u>10</u>
<u>Sand</u>	<u>10</u>	<u>30</u>
<u>Clay</u>	<u>30</u>	<u>45</u>
<u>Sand</u>	<u>45</u>	<u>70</u>

Information upon completion of well:

(1) Diameter 2 inches.

(2) Total Depth 70 feet.

(3) Water Level 60 feet below top of ground.

(4) Cased to 70, Size 2"


(5) Screen: Size 1 1/4, Length 5 FT

(6) Were there any formations sealed against pollution?
 _____ yes, _____ no.

If YES depth of formation _____

Why _____

Drillers Remarks: _____

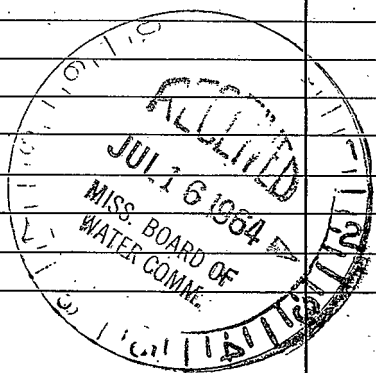

(Use Back Side)

Well No.

