

YALO.

MISSISSIPPI BOARD OF WATER COMMISSIONERS

CODED

CODED

L 22  
10-15-63

WATER WELL DRILLERS LOG

Date 10-15, 1963, Driller: J B Cain County Penola

(Name)

(1) Owner of Land: Ma Bruer  
(Name)  
Coffeeville Miss  
(Address)

Description & Color of Materials Sand, Clay, Red Clay, Shell, etc.	Thick- ness Feet	Depth Feet
<u>Blue Cl</u>	<u>0</u>	<u>20</u>
<u>Sand</u>	<u>20</u>	<u>80</u>
<u>Blue Cl</u>	<u>80</u>	<u>100</u>
<u>Sand</u>	<u>100</u>	<u>130</u>

(2) Location: 1/4, 15 Sec. 24 T. 6 R.  
4 miles E of Coffeeville  
(distance) (direction) (Nearest Town)

(3) Topography:  (Hilly)  (Flat)  (Level)

(4) Purpose of Well: Home  
(Domestic Irrigation  
Municipal, Industrial, Other)

Information upon completion of well:

(1) Diameter 2 inches.

(2) Total Depth 130 feet.

(3) Water Level 90 feet below top of ground.

(4) Cased to 130, Size 2"


(5) Screen: Size 1/4 length 5 FT  
Standard Steel Lock

(6) Were any formations sealed against pollution?  
\_\_\_\_\_ yes, \_\_\_\_\_ no.

If YES depth of formation \_\_\_\_\_

Why \_\_\_\_\_

Drillers Remarks: \_\_\_\_\_

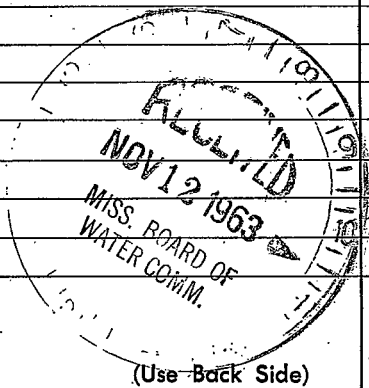

Well No.

