

YALO
223
8-2-64

WATER WELL DRILLERS LOG

CODED
CODED

Date: 8-2, 1964, Driller: J B Cain County: Panola
(Name)

(1) Owner of Land:	Description & Color of Materials Sand, Clay, Red Clay, Shell, etc.	Thick- ness Feet	Depth Feet
David a Liles (Name) Coffeeville Miss (Address)	300 ft Sand	0.58	50.68
(2) Location: 1/4, 17, Sec. 23, T 6, R 6 12 miles S E, of Coffeeville (distance) (direction) (Nearest Town)			
(3) Topography: <input checked="" type="checkbox"/> (Hilly) <input type="checkbox"/> (Flat) <input type="checkbox"/> (Level)			
(4) Purpose of Well: Home (Domestic Irrigation, Municipal, Industrial, Other)			


Information upon completion of well:

- (1) Diameter: 2" inches.
- (2) Total Depth: 68 feet.
- (3) Water Level: 50 feet below top of ground.
- (4) Cased to: 68, Size: 2"
- (5) Screen: Size: 1 1/4, Length: 5 FT.
- (6) Were any formations sealed against pollution?
_____ yes, _____ no.

If YES depth of formation _____

Why _____

Drillers Remarks: _____

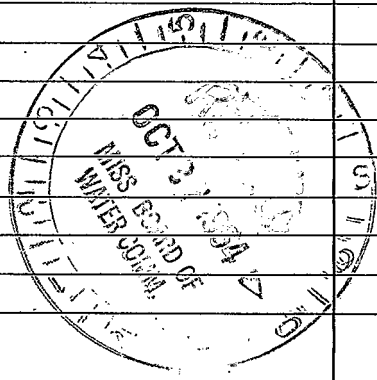

(Use Back Side)

Well No.

[The page contains extremely faint and illegible text, likely bleed-through from the reverse side of the document. No specific content can be transcribed.]