

YAWOB. WATER WELL DRILLERS LOG

CODED

FILED
Goldsboro
Gerrard

Date: 3-18-62, 1962, Driller: Lucien Rattiff County Gerrard
3-18-62 (Name)

(1) Owner of Land: Edd Madison
(Name)
Coffeenille, Missa
(Address)

(2) Location: 1/4, 18 1/4, Sec 24 T. 6 R.
_____ miles _____ of _____
(distance) (direction) (Nearest Town)

(3) Topography: _____
(Hilly) (Flat) (Level)

(4) Purpose of Well: _____
(Domestic Irrigation
Municipal, Industrial, Other)

Description & Color of Materials Sand, Clay, Red Clay, Shell, etc.	Thick- ness Feet	Depth Feet
Clay + sand	0	25
sand	35	47
sand	47	69
sand	69	91
sand	91	113
sand	113	135
sand	135	157
sand + clay	157	179
clay	179	201
shale	201	223
shale	223	245
sand	245	267
sand	267	285

Information upon completion of well:

(1) Diameter 2" inches.

(2) Total Depth 285 feet.

(3) Water Level 47' feet below top of ground.

(4) Cased to 285, Size 2"


(5) Screen: Size 2', Length 10'

(6) Were any formations sealed against pollution?
_____ yes, _____ no.

If YES depth of formation _____

Why _____

Drillers Remarks: _____

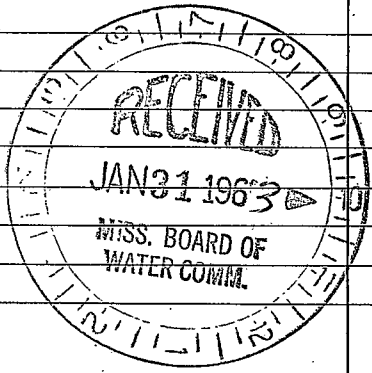

(Use Back Side)

Well No.

...the ...

...the ...

