

YALO.

L25
1-15-64

WATER WELL DRILLERS LOG

CODED
CODED

Date: 1-15, 1964, Driller: J B Cain County Panola

(Name)

(1) Owner of Land: James Milton
Coffeyville, Miss.
(Name) (Address)

(2) Location: 1/4, 15, 24, 6
3 miles E, of Coffeyville.
(distance) (direction) (Nearest Town)

(3) Topography: (Hilly) (Flat) (Level)

(4) Purpose of Well: Home
(Domestic Irrigation, Municipal, Industrial, Other)

Description & Color of Materials Sand, Clay, Red Clay, Shell, etc.	Thick- ness Feet	Depth Feet
Red Cl	0	20
Sand	20	60
Red Cl	20	72
Sand	72	90

Information upon completion of well:

(1) Diameter 2 inches.

(2) Total Depth 90 feet.

(3) Water Level 80 feet below top of ground.

(4) Cased to 90, Size 2"


(5) Screen: Size 1/4, Length 6"
Screen LOCKED IN

(6) Were any formations sealed against pollution?
yes, no.

If YES depth of formation

Why

Drillers Remarks: This is a
Plastic well

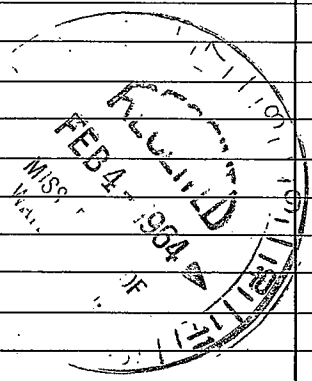

(Use Back Side)

Well No.

