

YALOB.

MISSISSIPPI BOARD OF WATER COMMISSIONERS

CODED  
CODED

WATER WELL DRILLERS LOG

L 27  
4-25-62  
7-25-62

J B Cain

Yalobusha

Date: \_\_\_\_\_, 19\_\_\_\_, Driller: \_\_\_\_\_ County \_\_\_\_\_

(Name)

HENRY NELSON

(1) Owner of Land: \_\_\_\_\_  
Rout 2 Coffeeville  
miss

Description & Color of Materials  
Sand, Clay, Red Clay, Shell, etc.

Thick-  
ness  
Feet

Depth  
Feet

Sand

20 108

S.W (Address)

(2) Location: \_\_\_\_\_ 1/4, \_\_\_\_\_ 1/4, Sec. \_\_\_\_\_, \_\_\_\_\_  
3 E 11 of Coffeeville  
miles (distance) (direction) (Nearest Town)

(3) Topography: \_\_\_\_\_  
(Hilly) (Flat) (Level)

(4) Purpose of Well: \_\_\_\_\_  
(Domestic Irrigation  
Municipal, Industrial, Other)

Information upon completion of well:

(1) Diameter 2 inches.

(2) Total Depth 108 feet.

(3) Water level 74 feet below top of ground.

(4) Cased to 108, Size 2"

(5) Screen: Size 1 1/4, Length 5 FT


(6) Were any formations sealed against pollution?

\_\_\_\_\_ yes, \_\_\_\_\_ no.

If YES depth of formation \_\_\_\_\_

Why \_\_\_\_\_

Drillers Remarks: \_\_\_\_\_

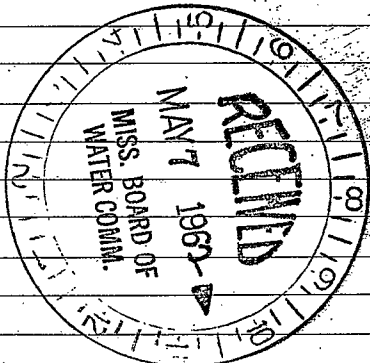

(Use Back Side)

Well No.

