

YALO.
L29
10-16-63

WATER WELL DRILLERS LOG

CODED
CODED

Date 10-16, 1963, Driller: J B Cain County Parola
(Name)


(1) Owner of Land:	Description & Color of Materials Sand, Clay, Red Clay, Shell, etc.	Thick- ness Feet	Depth Feet
<u>Mrs Bess Williams</u> (Name)	<u>Sandy Cl</u>	0	20
<u>Coffee Mills Mrs</u> (Address)	<u>Bluff Cl</u>	20	280
(2) Location: <u>1/4 1/4 246</u>	<u>Land</u>	280	305
<u>4</u> miles <u>E</u> of <u>Coffeyville</u> (distance) (direction) (Nearest Town)			
(3) Topography: _____ (Hilly) (Flat) (Level)			
(4) Purpose of Well: <u>Home</u> (Domestic Irrigation Municipal, Industrial, Other)			

Information upon completion of well:

- (1) Diameter 2 inches.
- (2) Total Depth 305 feet.
- (3) Water Level 22 feet below top of ground.
- (4) Cased to 300, Size 2"
- (5) Screen: Size NONE, Length _____
- (6) Were any formations sealed against pollution?
_____ yes, _____ no.

If YES depth of formation _____
Why _____

Drillers Remarks: _____

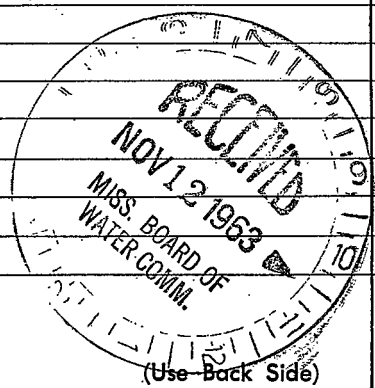

Well No.

