

WATER WELL DRILLERS LOG

YALO.
L 30

10-17-63

Date 10-17, 1963, Driller: J B Cant County Franklin

CODED
CODED

(Name)

(1) Owner of Land:	Description & Color of Materials Sand, Clay, Red Clay, Shell, etc.	Thick- ness Feet	Depth Feet
<u>Mrs Witham</u> (Name) <u>Coffeeville Miss</u> (Address)	<u>Sand</u>	<u>0</u>	<u>30</u>
(2) Location: <u>1/4, 12 1/2 46</u> Sec <u>4 T 6 R</u> <u>3 1/2</u> miles <u>E</u> of <u>Coffeeville</u> (distance) (direction) (Nearest Town)			
(3) Topography: <u>Level</u> (Hilly) (Flat) (Level)			
(4) Purpose of Well: (Domestic Irrigation Municipal, Industrial, Other)			

Information upon completion of well:

(1) Diameter 2 inches.

(2) Total Depth 80 feet.

(3) Water Level 70 feet below top of ground.


(4) Cased to 80, Size 2"

(5) Screen: Size 1/4, Length 6 FT

(6) Were any formations sealed against pollution?
_____ yes, _____ no.

If YES depth of formation _____
Why _____

Drillers Remarks: _____

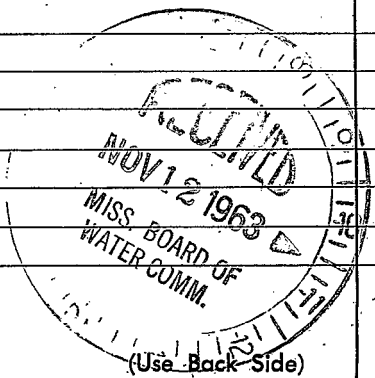

Well No.

