

YALOB.

MISSISSIPPI BOARD OF WATER COMMISSIONERS

CODED CODED

L31

4-9-629

62

WATER WELL DRILLERS LOG

J. B. CAIN

yalobur

Date: _____, 19____, Driller: _____ County _____

(Name)

B.F. WILSON

(1) Owner of Land: Rout 2 Coffeeville Miss
(Name)

Description & Color of Materials
Sand, Clay, Red Clay, Shell, etc.

Thick-
ness
Feet

Depth
Feet

20 10'

(2) Location: E 1/4, 11 1/4, Sec. 21 4 24
3 E Coffeeville
miles (distance) of (Nearest Town)

(3) Topography: Home
(Hilly) (Flat) (Level)

(4) Purpose of Well: _____
(Domestic Irrigation
Municipal, Industrial, Other)

Information upon completion of well:

(1) Diameter 2 inches.

(2) Total Depth 107 feet.

(3) Water level 56 feet below top of ground.

(4) Cased to 109, Size 2"


(5) Screen: Size 1 1/4, Length 5 FT

(6) Were any formations sealed against pollution?
yes, no.

If YES depth of formation _____

Why _____

Drillers Remarks: _____

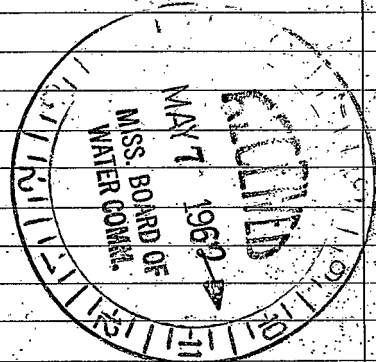

Well No.

(Use Back Side)

