

YALO.

MISSISSIPPI BOARD OF WATER COMMISSIONERS

L32

8-6-65

WATER WELL DRILLERS LOG

CODED

CODED

Date: 8-6, 1965, Driller: Jerry Robinson County Panola (Name)

(1) Owner of Land: Mr. C T Davis
(Name)
Water Valley Miss
(Address)

(2) Location: $\frac{1}{4}$, $\frac{1}{4}$, Sec. 14 24 6
T R
6 miles S.W. of W. Valley
(distance) (direction) (Nearest Town)

(3) Topography: V
(Hilly) (Flat) (Level)

(4) Purpose of Well: Home
(Domestic Irrigation
Municipal, Industrial, Other)

Description & Color of Materials Sand, Clay, Red Clay, Shell, etc.	Thick- ness Feet	Depth Feet
<u>Red Clay</u>	<u>0</u>	<u>20</u>
<u>Sand + Clay</u>	<u>20</u>	<u>60</u>
<u>Sand</u>	<u>60</u>	<u>70</u>

Information upon completion of well:

(1) Diameter 2 inches.

(2) Total Depth 70 feet.

(3) Water Level 40 feet below top of ground.


(4) Cased to 65, Size 2 in

(5) Screen: Size 3 in, Length 5 ft
outside

(6) Were there any formations sealed against pollution?
_____ yes, _____ no.

If YES depth of formation _____
Why _____

Drillers Remarks: Plastic

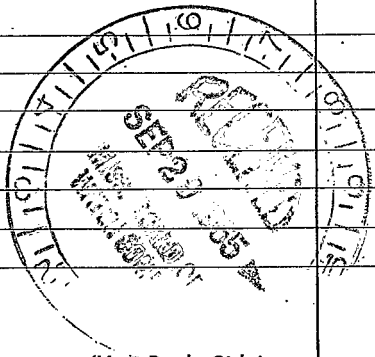

(Use Back-Side)

Well No.

100-1-12-12