

YALO.
L3A
2-15-63

MISSISSIPPI BOARD OF WATER COMMISSIONERS

WATER WELL DRILLERS LOG

CODED CODED

Date: 2-15, 1963, Driller: James R. Lipe County Panola
(Name)

(1) Owner of Land: Lewis Brewer
(Name)
OAKLAND, Miss.
(Address)

(2) Location: 1/4, 1/4, Sec. 3 246 T R
miles _____ of _____
(distance) (direction) (Nearest Town)

(3) Topography: Hilly
(Hilly) (Flat) (Level)

(4) Purpose of Well: Domestic
(Domestic Irrigation
Municipal, Industrial, Other)

Description & Color of Materials Sand, Clay, Red Clay, Shell, etc.	Thick- ness Feet	Depth Feet
<u>Clay</u>	<u>0</u>	<u>10</u>
<u>Sand & clay</u>	<u>10</u>	<u>30</u>
<u>Clay & gravel</u>	<u>30</u>	<u>45</u>
<u>gravel & sand</u>	<u>45</u>	<u>65</u>
<u>gravel</u>	<u>65</u>	<u>85</u>
<u>Sand</u>	<u>85</u>	<u>100</u>
<u>Clk. sand</u>	<u>100</u>	<u>120</u>
<u>W/ casing sand</u>	<u>120</u>	<u>167</u>

Information upon completion of well:

(1) Diameter 2" inches.

(2) Total Depth 167' feet.

(3) Water level 110' feet below top of ground.

(4) Cased to 159', Size 2"


(5) Screen: Size 1/4", Length 6'

(6) Were any formations sealed against pollution?
_____ yes, _____ no.

If YES depth of formation _____

Why _____

Drillers Remarks: _____

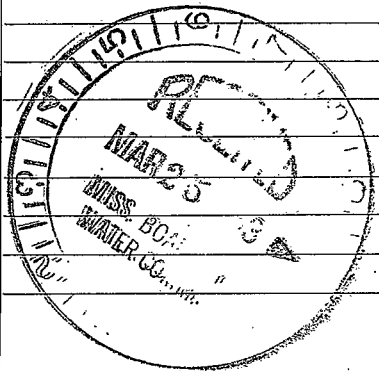

(Use Back Side)

Well No.

[The page contains extremely faint and illegible text, likely bleed-through from the reverse side of the document. No specific words or phrases can be discerned.]