

Seone H. Valley

MISSISSIPPI
BOARD OF WATER COMMISSIONERS
416 North State Street
Jackson, Mississippi 39201

CODED

WATER WELL DRILLERS LOG

~~YALOBUSHA~~
~~COLOMBIA~~
~~PL 39~~
5-15-72

May 15 1972 J.B. Cain Yalobusha
date well completed firm name county well located

LANDOWNER: Robert T. Williams, Sr.

description of formations encountered	from	to
	Clay	0
Sand	15	130

(mailing address)

WELL LOCATION:

sec. 4 T. 23 N. R. 6 E. S. W.
1/2 miles S of Coffeyville
(distance) (direction) (nearest town)

location

WELL PURPOSE: Home
(home, irrigation, municipal, industrial)

WELL COMPLETION DATA:

- (1) diameter (inches) 4" Well
- (2) total depth (feet) 130
- (3) static water level (feet) 105 below above top of ground.
- (4) casing PLASTIC 130 (material) (depth)
(size) if telescope see back.
- (5) screen 10' 120 (length) (depth to top)
4" PLASTIC (size) (material)
- (6) pump 1/2 10 (HP) (yield gpm)
Elect (type power)
- (7) electric log No (yes or no)

CODED

(organization running log)

(8) how well bottom plugged Plug


AUG 23 1972

DRILLERS REMARKS:

MISSISSIPPI
STATE
DEPARTMENT OF
WATER CONTROL

If well telescopes please sketch and show depths.

GROUND LEVEL

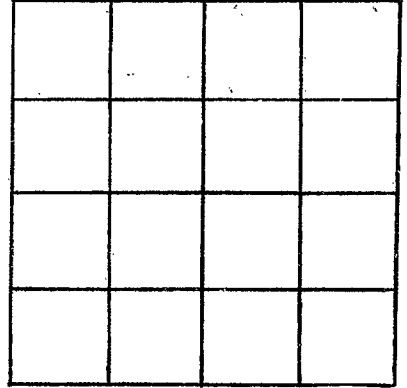

SECTION _____

Please indicate well location X.

ADDITIONAL INFORMATION

If more than one screen, show locations of each on sketch.