

MISSISSIPPI DEPARTMENT OF NATURAL RESOURCES

Bureau of Land and Water Resources

Southport Mall

P.O. Box 10631

Jackson, Mississippi 39209

CODED

WATER WELL DRILLERS LOG

YALOBUSHA
L 40
1183

date well completed 19

Dejeu Well
 firm name

Yalobusha
 county well located

LANDOWNER: Hays Company

Description of formations encountered

from

to

(mailing address)

Clay 0 3
m. White Sand 3 170

WELL LOCATION:

sec. 4 T. 240 S. R. 6 E
1/2 miles SE of Coffeyville
 (distance) (direction) (nearest town)

WELL PURPOSE:

(home, irrigation, municipal, industrial)

CODED

WELL COMPLETION DATA:

- (1) diameter (inches) 10
- (2) total depth (feet) 40
- (3) static water level (feet) 30 below above top of ground.
- (4) casing Steel 30
 (material) (depth)

if telescope see back.
 (size)

- (5) screen 20 20
 (length) (depth to top)
- 10" Steel
 (size) (material)

- (6) pump 15 300
 (HP) (yield gpm)
- Electric
 (type power)

- (7) electric log (yes or no)

(organization running log)

- (8) how well bottom plugged Does

DRILLERS REMARKS:

DEPT. OF NATURAL RESOURCES
 BUREAU OF LAND & WATER RESOURCES


FEB - 8 1960

RECEIVED

(7)

If well telescopes please sketch and show depths.

GROUND LEVEL

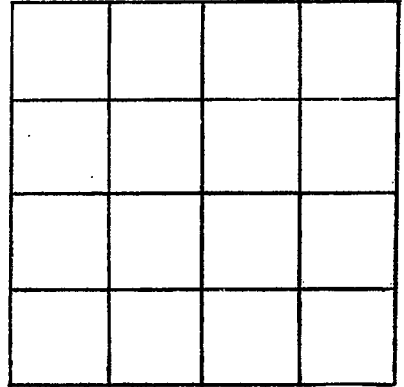

SECTION _____

Please indicate well location X.

ADDITIONAL INFORMATION

If more than one screen,
show locations of each on sketch.