

MISSISSIPPI DEPARTMENT OF NATURAL RESOURCES

Bureau of Land and Water Resources

Southport Mall

P.O. Box 10631

Jackson, Mississippi 39209

WATER WELL DRILLERS LOG

CODED

2/24/83
2/27/83

YALOBUSHA
L 41
1/83

date well completed

firm name

county well located

Dyer Well Yalobusha

LANDOWNER:

Harp Company

(mailing address)

description of formations encountered

from

to

Clay
in white sand

0 14
14 40

WELL LOCATION:

sec. 4 T 240 S R. 6E
1/2 miles SE of Coffeyville
 (distance) (direction) (nearest town)

WELL PURPOSE:

(home, irrigation, municipal, industrial)

WELL COMPLETION DATA:

CODED

- (1) diameter (inches) 10
- (2) total depth (feet) 40
- (3) static water level (feet) 30 below above top of ground.
- (4) casing Steel, 20,
 (material) (depth)

_____ if telescope see back.
 (size)

- (5) screen 20, 20
 (length) (depth to top)
- 10", _____
 (size) (material)

- (6) pump 15, 300
 (HP) (yield gpm)
- Electric
 (type power)

- (7) electric log (yes or no) no

_____ (organization running log)

- (8) how well bottom plugged plate

DRILLERS REMARKS:


DEPT. OF NATURAL RESOURCES
 BUREAU OF LAND & WATER RESOURCES

FEB - 3 1983

RECEIVED

If well telescopes please sketch and show depths.

GROUND LEVEL

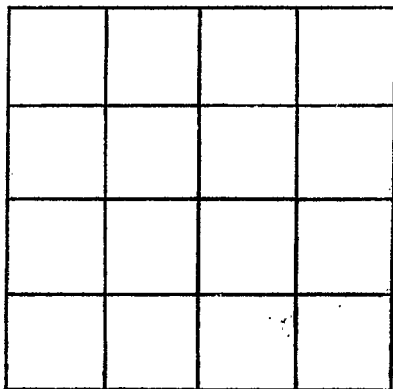

SECTION _____

Please indicate well location X.

ADDITIONAL INFORMATION

If more than one screen,
show locations of each on sketch.