

Yalobusha  
16 2000  
3-17-76

MISSISSIPPI  
 BOARD OF WATER COMMISSIONERS  
 416 North State Street  
 Jackson, Mississippi 39201

WATER WELL DRILLERS LOG

3-17 <sup>156</sup> 1976 Lipe Well Co Yalobusha  
 date well completed firm name county well located

LANDOWNER:	description of formations encountered	from	to
<u>Charles Smith</u>	<u>Top Soil</u>	<u>0</u>	<u>20</u>
<u>Coffeerville Miss.</u> (mailing address)	<u>sand</u>	<u>20</u>	<u>40</u>
	<u>clay</u>	<u>40</u>	<u>60</u>
WELL LOCATION: sec. <u>3</u> T. <u>24</u> S. R. <u>6</u> E. <u>1</u> miles <u>east</u> of <u>Coffeerville</u> (distance) (direction) (nearest town)	<u>clay</u>	<u>60</u>	<u>80</u>
	<u>sand and clay</u>	<u>80</u>	<u>100</u>
	<u>clay</u>	<u>100</u>	<u>120</u>
	<u>sand</u>	<u>120</u>	<u>140</u>
	<u>clay</u>	<u>140</u>	<u>160</u>
	<u>clay</u>	<u>160</u>	<u>175</u>

WELL PURPOSE:  
 (home) irrigation, municipal, industrial)


- WELL COMPLETION DATA:
- (1) diameter (inches) 4
  - (2) total depth (feet) 175
  - (3) static water level (feet) 10 below above top of ground.
  - (4) casing PVC 163  
(material) (depth)  
4 if telescope see back.  
(size)
  - (5) screen 12 163  
(length) (depth to top)  
4 PVC  
(size) (material)
  - (6) pump 3/4 10  
(HP) (yield.gpm)  
elec.  
(type power)
  - (7) electric log no  
(yes or no)  
no  
(organization running log)
  - (8) how well bottom plugged PVC  
cap

RECEIVED  
 MAR 29 1976

DRILLERS REMARKS:  
 MISS. BD. OF WATER COMMISSIONERS

If well telescopes please sketch and show depths.

GROUND LEVEL

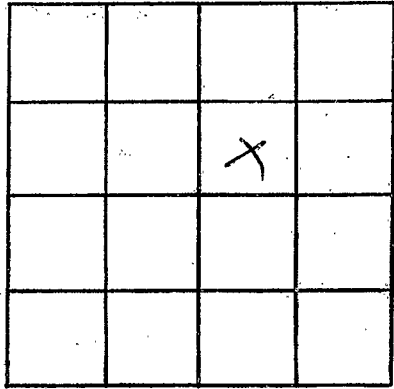

SECTION 3

Please indicate well location X.

ADDITIONAL INFORMATION

If more than one screen,  
show locations of each on sketch.