

YALOBUSHA
L 200
8-19-77

MISSISSIPPI
BOARD OF WATER COMMISSIONERS
416 North State Street
150 Jackson, Mississippi 39201

WATER WELL DRILLERS LOG

8-19-77¹⁹ date well completed
North miss Edging Co firm name
Yalobusha county well located

LANDOWNER J. E. Madison
Coffeyville miss
Rt 1
(mailing address)

description of formations encountered	from	to
Clay	0	8
Sand	8	95
Blue Clay	95	128
Sand	128	130
Blue Clay	130	228
Sand	228	250

WELL LOCATION:
sec. 19 T 24 N R. 6 E
1/2 miles S W of Coffeyville
(distance) (direction) (nearest town)

WELL PURPOSE: Home
(home, irrigation, municipal, industrial)

- WELL COMPLETION DATA:
- (1) diameter (inches) 4
 - (2) total depth (feet) 250
 - (3) static water level (feet) 28 below top of ground.
 - (4) casing Plastic 180
(material) (depth)
(size) If telescope see back.
 - (5) screen No
(length) (depth to top)
 - (6) pump 3/4 15
(HP) (yield gpm)
Elect
(type power)
 - (7) electric log (yes or no)
 - (organization running log)
 - (8) how well bottom plugged Open


RECEIVED
AUG 29 1977

OF WATER COMMISSIONERS

DRILLERS REMARKS: A Gain
Rt 3 Batesville
Miss

If well telescopes please sketch and show depths.

GROUND LEVEL

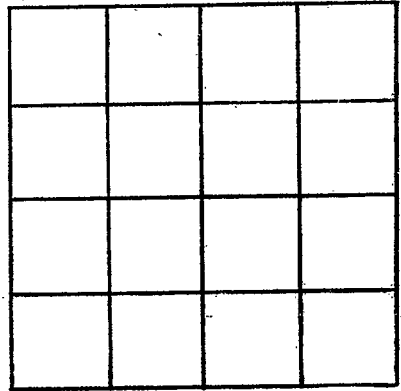

SECTION _____

Please indicate well location X.

ADDITIONAL INFORMATION

If more than one screen, show locations of each on sketch.