

YALOBUSHA

M 8

6-10-73

MISSISSIPPI BOARD OF WATER COMMISSIONERS  
416 North State Street  
Jackson, Mississippi 39201

location  
**CODED**

WATER WELL DRILLERS LOG

June 10 1973 Chorley Lorum Yalobusha  
date well completed firm name county well located

LANDOWNER:

~~Rufus Hallman~~  
Rufus Hallman  
Copperville Miss  
(mailing address)

description of formations encountered

description of formations encountered	from	to
white clay	0	22
draped blue + white sand	22	44
blue shale	44	170
blue + grey sand	170	200

WELL LOCATION:

sec 34 T29S R2E W  
16 miles SE of Copperville  
(distance) (direction) (nearest town)

Per 6/17/74

WELL PURPOSE:

(home, irrigation, municipal, industrial)

WELL COMPLETION DATA:

- (1) diameter (inches) 4"
- (2) total depth (feet) 200'
- (3) static water level (feet) 30' below top of ground.
- (4) casing plastic 170' (material) (depth)
- (size) If telescope see back.
- (5) screen 20' 170' (length) (depth to top)
- (size) 2" plastic (material)
- (6) pump 1 (HP) 6 (yield gpm)
- Electric (type power)
- (7) electric log yes (yes or no)

CODED

(organization running log)

(8) how well bottom plugged plugged


DRILLERS REMARKS:

DECEMBER 1973  
MAY 22 1974

MISS. BD. OF WATER COMMISSIONERS

If well telescopes please sketch and show depths.

GROUND LEVEL

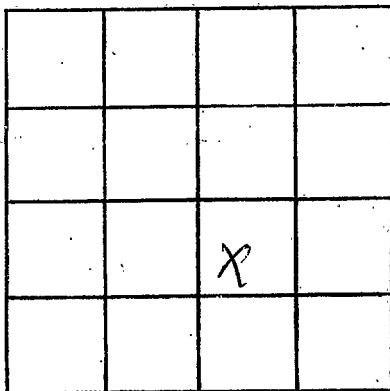

SECTION 34

Please indicate well location X.

ADDITIONAL INFORMATION

If more than one screen, show locations of each on sketch.