

YALOBUSHA

1-31-75

M 10

1-31-75

date well completed

MISSISSIPPI BOARD OF WATER COMMISSIONERS
416 North State Street
Jackson, Mississippi 39201

CODED

WATER WELL DRILLERS LOG

J B Cain
firm name

Yalobusha
county well located

LANDOWNER: J W Stuckland

Description of formations encountered

from

to

Coffeyville Miss
(mailing address)

Clay 0 150
Clay to Sand-S- 150 2100
Water Sand 2100 300

WELL LOCATION:

sec. 34 T 24 N R 7 E
SEast W
7 miles West of Coffeyville
(distance) (direction) (nearest town)

WELL PURPOSE: Home
(home, irrigation, municipal, industrial)

WELL COMPLETION DATA:

CODED

- (1) diameter (inches) 4"
- (2) total depth (feet) 300"
- (3) static water level (feet) 30' below above top of ground.
- (4) casing Plastic 180'
(material) (depth)

(size) If telescope see back.

- (5) screen 0
(length) (depth to top)
4" Plastic
(size) (material)

- (6) pump 1/2 (HP) 10 (yield gpm)
Elect
(type power)

- (7) electric log NO
(yes or no)

(organization running log)

- (8) how well bottom plugged DPEN Bottom


FEB 14 1975

DRILLERS REMARKS:

MISS. Bd. OF WATER COMMISSIONERS

If well telescopes please sketch and show depths.

GROUND LEVEL

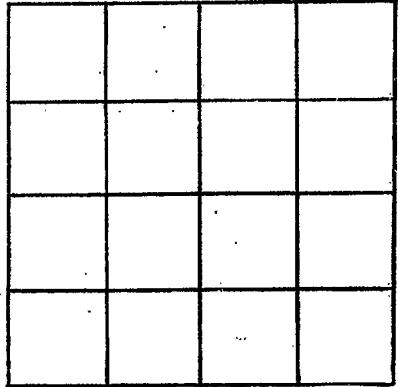

SECTION _____

Please indicate well location X.

ADDITIONAL INFORMATION

If more than one screen,
show locations of each on sketch.