

YALOBUSHA

M 11

2-14-75

2-14-75
date well completed

BOARD OF WATER COMMISSIONERS
416 North State Street
Jackson, Mississippi 39201
Big Steam Well Drilling Co. CODED
WATER WELL DRILLERS LOG

J B Cain
firm name

Yalobusha Co.
county well located

LANDOWNER: Rufus Halperman

Coffeyville Miss
(mailing address)

WELL LOCATION:

sec. 34 T 24 N^W R 7 E^W
S W

7 miles East of Coffeyville
(distance) (direction) (nearest town)

WELL PURPOSE: Home
(home, irrigation, municipal, industrial)

WELL COMPLETION DATA:

- (1) diameter (inches) 4" x 2"
- (2) total depth (feet) 280'
- (3) static water level (feet) 30' below above top of ground.
- (4) casing 4x2 (material) 280' (depth)

4x2 (size) if telescope see back.

- (5) screen 40' (length) (depth to top)
2" (size) Plastic (material)

- (6) pump 3/4 (HP) 10 (yield gpm)
Elect (type power)

- (7) electric log NO (yes or no)

(organization running log)

- (8) how well bottom plugged Plug

DRILLERS REMARKS:

description of formations encountered	from	to
Blue Clay	0	200
Sand &	200	210
Blue Clay	210	260
Black Egg Sand	260	280

CODED

RECEIVED
MAR - 5 1975


MISS. BD. OF WATER COMMISSIONERS

If well telescopes please sketch and show depths.

GROUND LEVEL



If more than one screen, show locations of each on sketch.

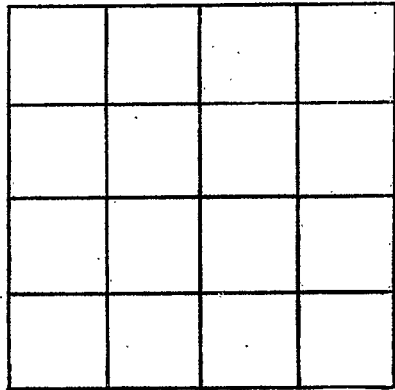

SECTION _____

Please indicate well location X.

ADDITIONAL INFORMATION

A series of horizontal lines for providing additional information.