

Yalobusha
M 12
9-16-75

MISSISSIPPI
 BOARD OF WATER COMMISSIONERS
 416 North State Street
 Jackson, Mississippi 39201

CODED
 DED

WATER WELL DRILLERS LOG

9-16-75 19 J. B. Cain Yalobusha
 date well completed Jim Cain county well located

LANDOWNER: Clayton Horton
RT 1 Coffeyville Mo
 (mailing address)

description of formations encountered	from	to
<u>Blue Clay</u>	<u>0</u>	<u>110</u>
<u>Clay Rock Ledger</u>	<u>110</u>	<u>200</u>
<u>Sand</u>	<u>200</u>	<u>250</u>

WELL LOCATION:
 sec 13-24 T 24 N 156
 R 7 E 156
9 miles E of Coffeyville
 (distance) (direction) (nearest town)

WELL PURPOSE: Home
 (home, irrigation, municipal, industrial)

- WELL COMPLETION DATA:
- (1) diameter (inches) 4"
 - (2) total depth (feet) 250
 - (3) static water level (feet) 50 below top of ground.
 - (4) casing Plastic, 150,
 (material) (depth)
 (size) if telescope see back.
 - (5) screen NO,
 (length) (depth to top)
NO,
 (size) (material)
 - (6) pump 1/2, 15,
 (HP) (yield gpm)
Elect
 (type power)
 - (7) electric log NO
 (yes or no)
 - (organization running log)
 - (8) how well bottom plugged Open


RECEIVED
 SEP 25 1975

MISS. BU. OF WATER COMMISSIONERS

DRILLERS REMARKS:

If well telescopes please sketch and show depths.

GROUND LEVEL

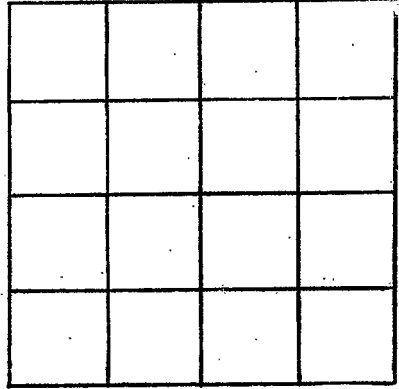

SECTION _____

Please indicate well location X.

ADDITIONAL INFORMATION

If more than one screen, show locations of each on sketch.