

YALOBUSHA
M13

GW04025 MISSISSIPPI
BOARD OF WATER COMMISSIONERS
416 North State Street
Jackson, Mississippi 39201

CODED

11/78

Eng # SA

Nov 78

WATER WELL DRILLERS LOG

Robert E. RATLIFF Co Inc Yalobusha

date well completed

firm name

county well located

LANDOWNER: Youngs

WATER

Assoc. Well #2

description of formations encountered

from

to

Top Soil	0	20
SAND	20	350
SHALE + SAND STREAKS	350	650
SAND	650	700

mailing address

LOCATION:

sec. 7 T. 23 N R. 7 E
30 miles East of GRENADA
(distance) (direction) (nearest town)

WELL PURPOSE: municipal
(home, irrigation, municipal, industrial)

WELL COMPLETION DATA:

- (1) diameter (inches) 10 x 4
- (2) total depth (feet) 700
- (3) static water level (feet) 138 below top of ground.
- (4) casing steel, 610 (material) (depth) 10" (size) if telescope see-back.
- (5) screen 30' (length) 670 (depth to top) 4" (size) 55 (material)
- (6) pump 25 (HP) 130 (yield gpm) electric (type power)
- (7) electric log YES (yes or no) STATE (organization running log)
- (8) how well bottom plugged BPO

Miss. Board of Water Comm.



SEP 12 1978

DRILLERS REMARKS:

RECEIVED

If well telescopes please sketch and show depths.

GROUND LEVEL

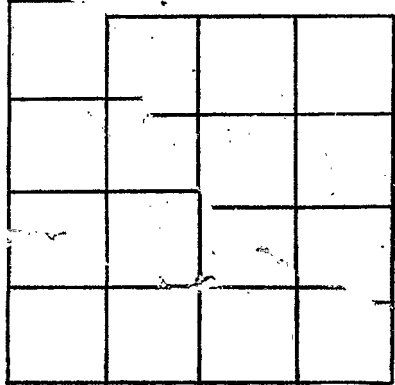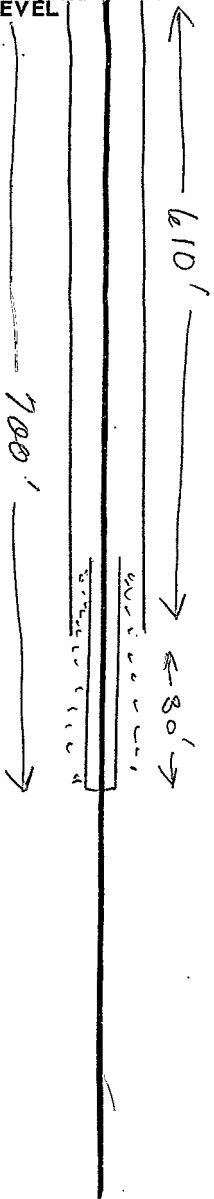

SECTION _____

Please indicate well location X.

ADDITIONAL INFORMATION

A series of horizontal lines for writing additional information.

If more than one screen, show locations of each on sketch.