

YA200

A 15

WATER WELL DRILLERS LOG

CODED

8-63

Date: Aug. 1963, Driller: David Benny County Yesso

(1) Owner of Land: Cedar Hills School

Yesso City, Miss

(2) Location: 1/4, 1/4, Sec. 21 T13R24W 8 miles NW of Yesso

(3) Topography: Flat

(4) Purpose of Well: Domestic

Table with 3 columns: Description & Color of Materials, Thickness Feet, Depth Feet. Rows include Clay, Sandy clay, and Sand.

Information upon completion of well:

(1) Diameter 2 inches.

(2) Total Depth 100 feet.

(3) Water Level 22 feet below top of ground.

(4) Cased to 100, Size 2"

(5) Screen: Size 5, Length 2"


(6) Were any formations sealed against pollution? yes, no.

If YES depth of formation

Why

Drillers Remarks:

CODED

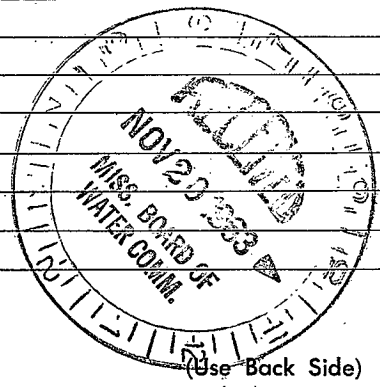

Well No.

