

MISSISSIPPI
BOARD OF WATER COMMISSIONERS
416 North State Street
Jackson, Mississippi 39201

CODED

WATER WELL DRILLERS LOG

YAZOO
A 16
10-30-72

Oct. 30 1972 E.M. "Bud" Cresswell Yazoo
date well completed firm name county well located


LANDOWNER:	description of formations encountered	from	to
Dottie JACKSON CARTER, Miss. (mailing address)	Clay Sand gravel	0 60	60 89
WELL LOCATION:			
sec. <u>7</u> T <u>13</u> N R. <u>2</u> E at Carter miles (distance) of (direction) of (nearest town)			
WELL PURPOSE: Domestic (home, irrigation, municipal, industrial)			
WELL COMPLETION DATA:			
(1) diameter (inches) <u>2</u>	CODED		
(2) total depth (feet) <u>89</u>			
(3) static water level (feet) <u>18</u> below top of ground.			
(4) casing <u>steel 84</u> (material) (depth)			
<u>2</u> if telescope see back. (size)			
(5) screen <u>5 84</u> (length) (depth to top)			
<u>2</u> <u>Stainless</u> (size) (material)			
(6) pump <u>3/4 10</u> (HP) (yield gpm)			
<u>0</u> (type power)			
(7) electric log <u>0</u> (yes or no)			
<u>0</u> (organization running log)			
(8) how well bottom plugged			
Steel plug			
DRILLERS REMARKS:			

NOV - 2 1972

MISS. GO. OF
WATER

If well telescopes please
sketch and show depths.

GROUND LEVEL

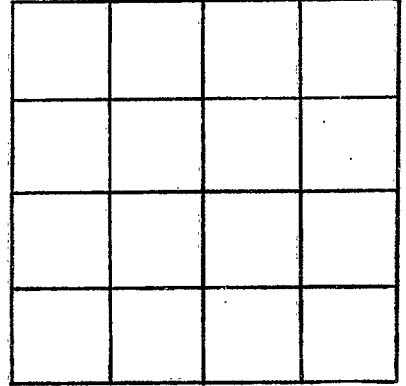

SECTION _____

Please indicate well location X.

ADDITIONAL INFORMATION

If more than one screen,
show locations of each on sketch.