

Gw 13011

MISSISSIPPI  
BOARD OF WATER COMMISSIONERS  
416 North State Street,  
Jackson, Mississippi 39201

**CODED**

WATER WELL DRILLERS LOG

YAZOO
A17
7/73
log # 251
6/19

19 73 Singer-Davne Central Div. Yazoo  
 date well completed firm name county well located

LANDOWNER:  
Renshaw Water Association  
Yazoo City, Miss.  
(mailing address)

WELL LOCATION:  
sec 35 T 13 N R 2 W  
 (distance) miles (direction) of (nearest town)

WELL PURPOSE: Domestic  
(home, irrigation, municipal, industrial)

WELL COMPLETION DATA:

(1) diameter (inches) 6"

(2) total depth (feet) 958'

(3) static water level (feet) 171' below above top of ground.

(4) casing Steel 900'  
(material) (depth)

6" if telescope see back.  
(size) 50' 3/4"

(5) screen 41' 907'  
(length) (depth to top)

4" S.S.W.W.  
(size) (material)

(6) pump 15 100  
(HP) (yield gpm)

Electric  
(type power)

(7) electric log yes  
(yes or no)

Miss. Geo. Survey  
(organization running log)

(8) how well bottom plugged Valve

description of formations encountered	from	to
Fill dirt	0	4
Clay (soft)	4	75
Hard Clay	75	102
Sand	102	112
Sandy Clay	112	194
Hard Clay	194	211
Sand & Clay (streaks)	211	286
Clay	286	311
Sand	311	410
Clay (streaks)	410	425
Sand	425	488
Sandy Shale	488	555
Hard Clay	555	580
Sandy Clay	580	658
Hard Shale	658	677
Rock	677	678
Clay & Sand streaks	678	721
Rock	721	722
Clay	722	728
Rock	728	729
Hard Clay	729	814
Sand	814	833
Hard Shale	833	860
Sand	860	957


**JUL 16 1973**

DRILLERS REMARKS:

MIC.

If well telescopes please sketch and show depths.

GROUND LEVEL

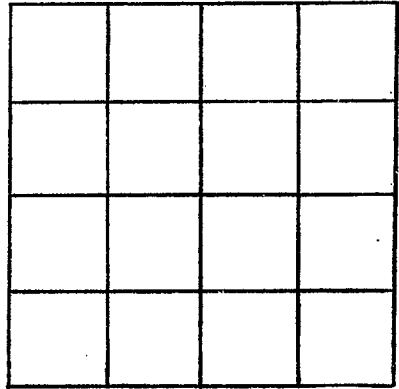

SECTION \_\_\_\_\_

Please indicate well location X.

ADDITIONAL INFORMATION

If more than one screen, show locations of each on sketch.